


- V-500**  
INLET FILTER/SEPARATOR  
6 3/4" OD x 3'-8" SM/SM  
1400 PSIG DP @ -20/150°F  
1/2" CA VERTICAL C/W (1) FORDUS  
MEDIA 0.5 MICRON COALESCING  
FILTER ELEMENT #0CA36003V
- V-501**  
AMINE CONTACTOR  
10 1/2" OD x 45'-3 1/4" SM/SM  
1400 PSIG DP @ -20/150°F  
1800 RPM, 7.5 HP MOTOR  
1/4" CA VERTICAL  
20 BUBBLE CAP TRAYS  
INTEGRAL SWEET FUEL  
GAS SCRUBBER DESIGN  
CONDITIONS AS ABOVE
- P-509A/B**  
AMINE CHARGE PUMP  
UNION DX-5 DUPLEX  
3/8" BORE, 7.5 HP MOTOR  
36/60/460 VAC  
5.02 USGPM FLOWRATE
- E-502**  
AERIAL REFLUX CONDENSER  
230,000 BTU/HR DUTY  
14.9 PSIG DP @ -20/300°F + 1/8" CA  
AUTO LOUVRES, 7 1/2 HP 3/60/480  
5 HP, 1750 RPM, 60" FAN;  
36/60/480 VAC, X.P. MOTOR
- E-503**  
AERIAL AMINE COOLER  
209,000 BTU/HR DUTY  
14.9 PSIG DP @ -20/300°F + 1/8" CA  
10 3/4" OD x 47'-3 3/4" SM/SM (NON-CODE)  
14.9 PSIG DP @ -20/300°F + 1/8" CA  
(1) 20' SECTION SS PACKING  
(1) 15' SECTION SS PACKING  
INTEGRAL REFLUX ACCUMULATOR
- H-510**  
AMINE REBOILER  
450,000 BTU/HR DUTY  
14.9 PSIG DP @ -20/300°F + 1/8" CA  
36" OD x 10'-0" LG REBOILER  
30" OD x 8'-0" LG AMINE SURGE  
12 3/4" OD REMOVABLE FIRETUBE  
12 3/4" OD x 15'-0" HIGH STACK  
500,000 BTU/HR FLAME ARRESTOR
- P-504A/B**  
REFLUX PUMP  
DEANLINE 3/4" DL, 316SS  
2 1/2" LG, 1 1/2" HP, 3600 RPM  
36/480/60 Hz X.P. MOTOR
- F-508**  
AMINE PARTICULATE FILTER  
PECO #SS-A-3316  
9" W (4) ELEMENTS  
175 PSIG @ 250°F
- F-507**  
AMINE CHARCOAL FILTER  
PECO #11-1-720  
4" W (7) ELEMENTS  
175 PSIG @ 250°F
- V-511**  
ANTIFOAM SHOTPOT  
8 1/2" O.D. x 24" H.P.  
350 PSIG D.P.  
-20/200°F + 1/16" CA
- H-525A/B**  
GLYCOL HEATER  
RUFFNECK HP 3-16  
120/1/60 1/4 H.P.
- P-512**  
MAKE-UP PUMP  
BY OTHERS
- T-513**  
WATER TANK  
BY OTHERS

 

**VALVE TAGGING**

VALVE TYPES: BA-BALL, GA-GATE, GL-GLOBE, CH-CHECK, NE-NEEDLE, BB-NEEDLE (BLOCK w/BLEED)

END CONNECTIONS: 0 = RFF, 1 = RTG, 2 = SW, 3 = NPT x SW, 4 = NPT, 5 = TRIM, 6 = STANDARD, 7 = SOUR

PRESSURE RATINGS: 1 = 150# ANSI, 3 = 300# ANSI, 6 = 600# ANSI, 8 = 800# API, 9 = 900# ANSI, 15 = 1500# ANSI/1500# API

SUFFIX: F = FULL PORT, S = SWING CHECK, P = PISTON CHECK

**MECHANICAL FLOWSHEET**  
**AMINE SWEETENING FACILITY**  
LOCATION: BULRUSH LSD: c-53-F/

CUSTOMER: MORRISON PETROLEUMS LTD. 5% TARTAN ENGINEERING

DATE	96-04-26	SCALE	N.T.S.
DRWN	JF	CHKD	KEW
APPD	B.J.	REV. DATE	REV. BY

The information contained herein is the confidential property of Alco Gas and Oil Production Equipment Ltd. and is not for publication. The information is loaned on the understanding that no part thereof shall be copied or communicated to a third party without authorization in writing from Alco Gas and Oil Production Equipment Ltd.

**ALCO GAS AND OIL PRODUCTION EQUIPMENT LTD.**

SHOP ORDER: A-17040  
REVISION: DWG: A-

NO.	DATE	BY	DESCRIPTION
4	AUG 96	KRT	AS BUILT
3	JULY 96	KRT	GENERAL REVISIONS AS PER APPROVAL DRAWINGS
2	06/27	GDB B.J.	ISSUED FOR CONSTRUCTION
1	06/27	GDB	ISSUED FOR CONSTRUCTION
0		JF	ISSUED FOR APPROVAL

REFERENCE DRAWINGS: A-20348 LAYOUT/ASSEMBLY  
DWG. DESCRIPTION: REV. DATE: REV. BY: DESCRIPTION

**V-500**  
**INLET FILTER/SEPARATOR**

6 5/8" OD x 5'-8" SM/SM  
1400 PSIG DP @ -20/150°F  
1/8" CA, VERTICAL c/w (1) POROUS  
MEDIA 0.3 MICRON COALESCING  
FILTER ELEMENT #GC34360E03V

**V-501**  
**AMINE CONTACTOR**

10 3/4" OD x 45'-2 1/4" SM/SM  
1400 PSIG DP @ -20/150°F  
1/8" CA, VERTICAL  
20 BUBBLE CAP TRAYS  
c/w INTEGRAL SWEET FUEL  
GAS SCRUBBER DESIGN  
CONDITIONS AS ABOVE

**P-509A/B**  
**AMINE CHARGE PUMP**

UNION DX-5 DUPLEX  
1800 RPM, 7.5 HP MOTOR  
3ø/60/460 VAC.  
5.02 USGPM FLOWRATE

**E-502**  
**AERIAL REFLUX CONDENSER**


230,000 BTU/HR DUTY  
14.9 PSIG DP @ -20/300°F + 1/8" CA  
AUTO LOUVRES, 7 1/2 HP 3/60/480  
5 HP, 1750 RPM, 60" FAN,  
3ø/60/480 VAC. X.P. MOTOR

**E-503**  
**AERIAL AMINE COOLER**

209,000 BTU/HR DUTY  
1400 PSIG DP @ -20/300°F + 1/16" CA  
AUTO LOUVRES w/ ACTUATOR  
& AUTO RECIRCULATION

**V-505/V-506**  
**AMINE REGENERATOR/  
REFLUX ACCUMULATOR**

14.9 PSIG DP @ -20/300°F + 1/8" CA  
(1) 20' SECTION SS PACKING  
(1) 15' SECTION SS PACKING  
INTEGRAL REFLUX ACCUMULATOR

 

BUILDING WALL INLET LOUVRES  
MANUALLY ADJUSTABLE

F.C. BUILDING WALL (DISCHARGE LOUVRES)

E-502/E-503  
INSULATE LINES BY LOUVRES

NO POCKETS  
START-UP BY-PASS

5-VALVE MANIFOLD  
FSL 5090

SET @ 600 PSIG FALLING

PSV 5091 SET @ 1400 PSIG

**V-506**  
REGENERATOR/  
ACCUMULATOR

3 5/8" SM/SM (NON-CODE)  
@ -20/300°F + 1/8" CA  
SECTION SS PACKING  
SECTION SS PACKING  
REFLUX ACCUMULATOR

**H-510**  
AMINE REBOILER

450,000 BTU/HR DUTY  
14.9 PSIG DP @ -20/300°F + 1/8" CA  
36" OD x 10'-0" LG REBOILER  
30" OD x 8'-0" LG AMINE SURGE  
12 3/4" OD REMOVABLE FIRETUBE  
12 3/4" OD x 15'-0" HIGH STACK  
500,000 BTU/HR FLAME ARRESTOR

**P-504A/B**  
REFLUX PUMP

DEANLINE 3/4 DL, 316SS  
c/w 1 1/2 HP, 3600 RPM  
3φ/480/60 Hz X.P. MOTOR

**F-508**  
AMINE PARTICULATE  
FILTER

PECO #55-A-336  
9W (4) ELEMENTS  
175 PSIG @ 250°F

**F-507**  
AMINE CHARCOAL  
FILTER

PECO #11-1-720  
9W (1) ELEMENT  
175 PSIG @ 250°F

**V-511**  
ANTIFOAM SHOTPOT

8 5/8" O.D. x 24" 5/8"  
350 PSIG D.P.  
@ -20/200°F + 1/16" CA

**H-525A/B**  
GLYCOL HEATER

RUFFNECK HP 3-16  
120/1/60 1/4 H.P.

**P-512**  
MAKE-UP PUMP

BY OTHERS

**T-513**  
WATER TANK

BY OTHERS

BUILDING WALL INLET LOUVRES  
FULLY ADJUSTABLE

BUILDING WALL (DISCHARGE LOUVRES)

**E-502/E-503**

PLENUM

INSULATE LINES  
BY LOUVRES


5-VALVE  
MANIFOLD

1" NPT

1"x1" NPT  
SET @  
1400 PSIG


STR  
120A

STR  
160

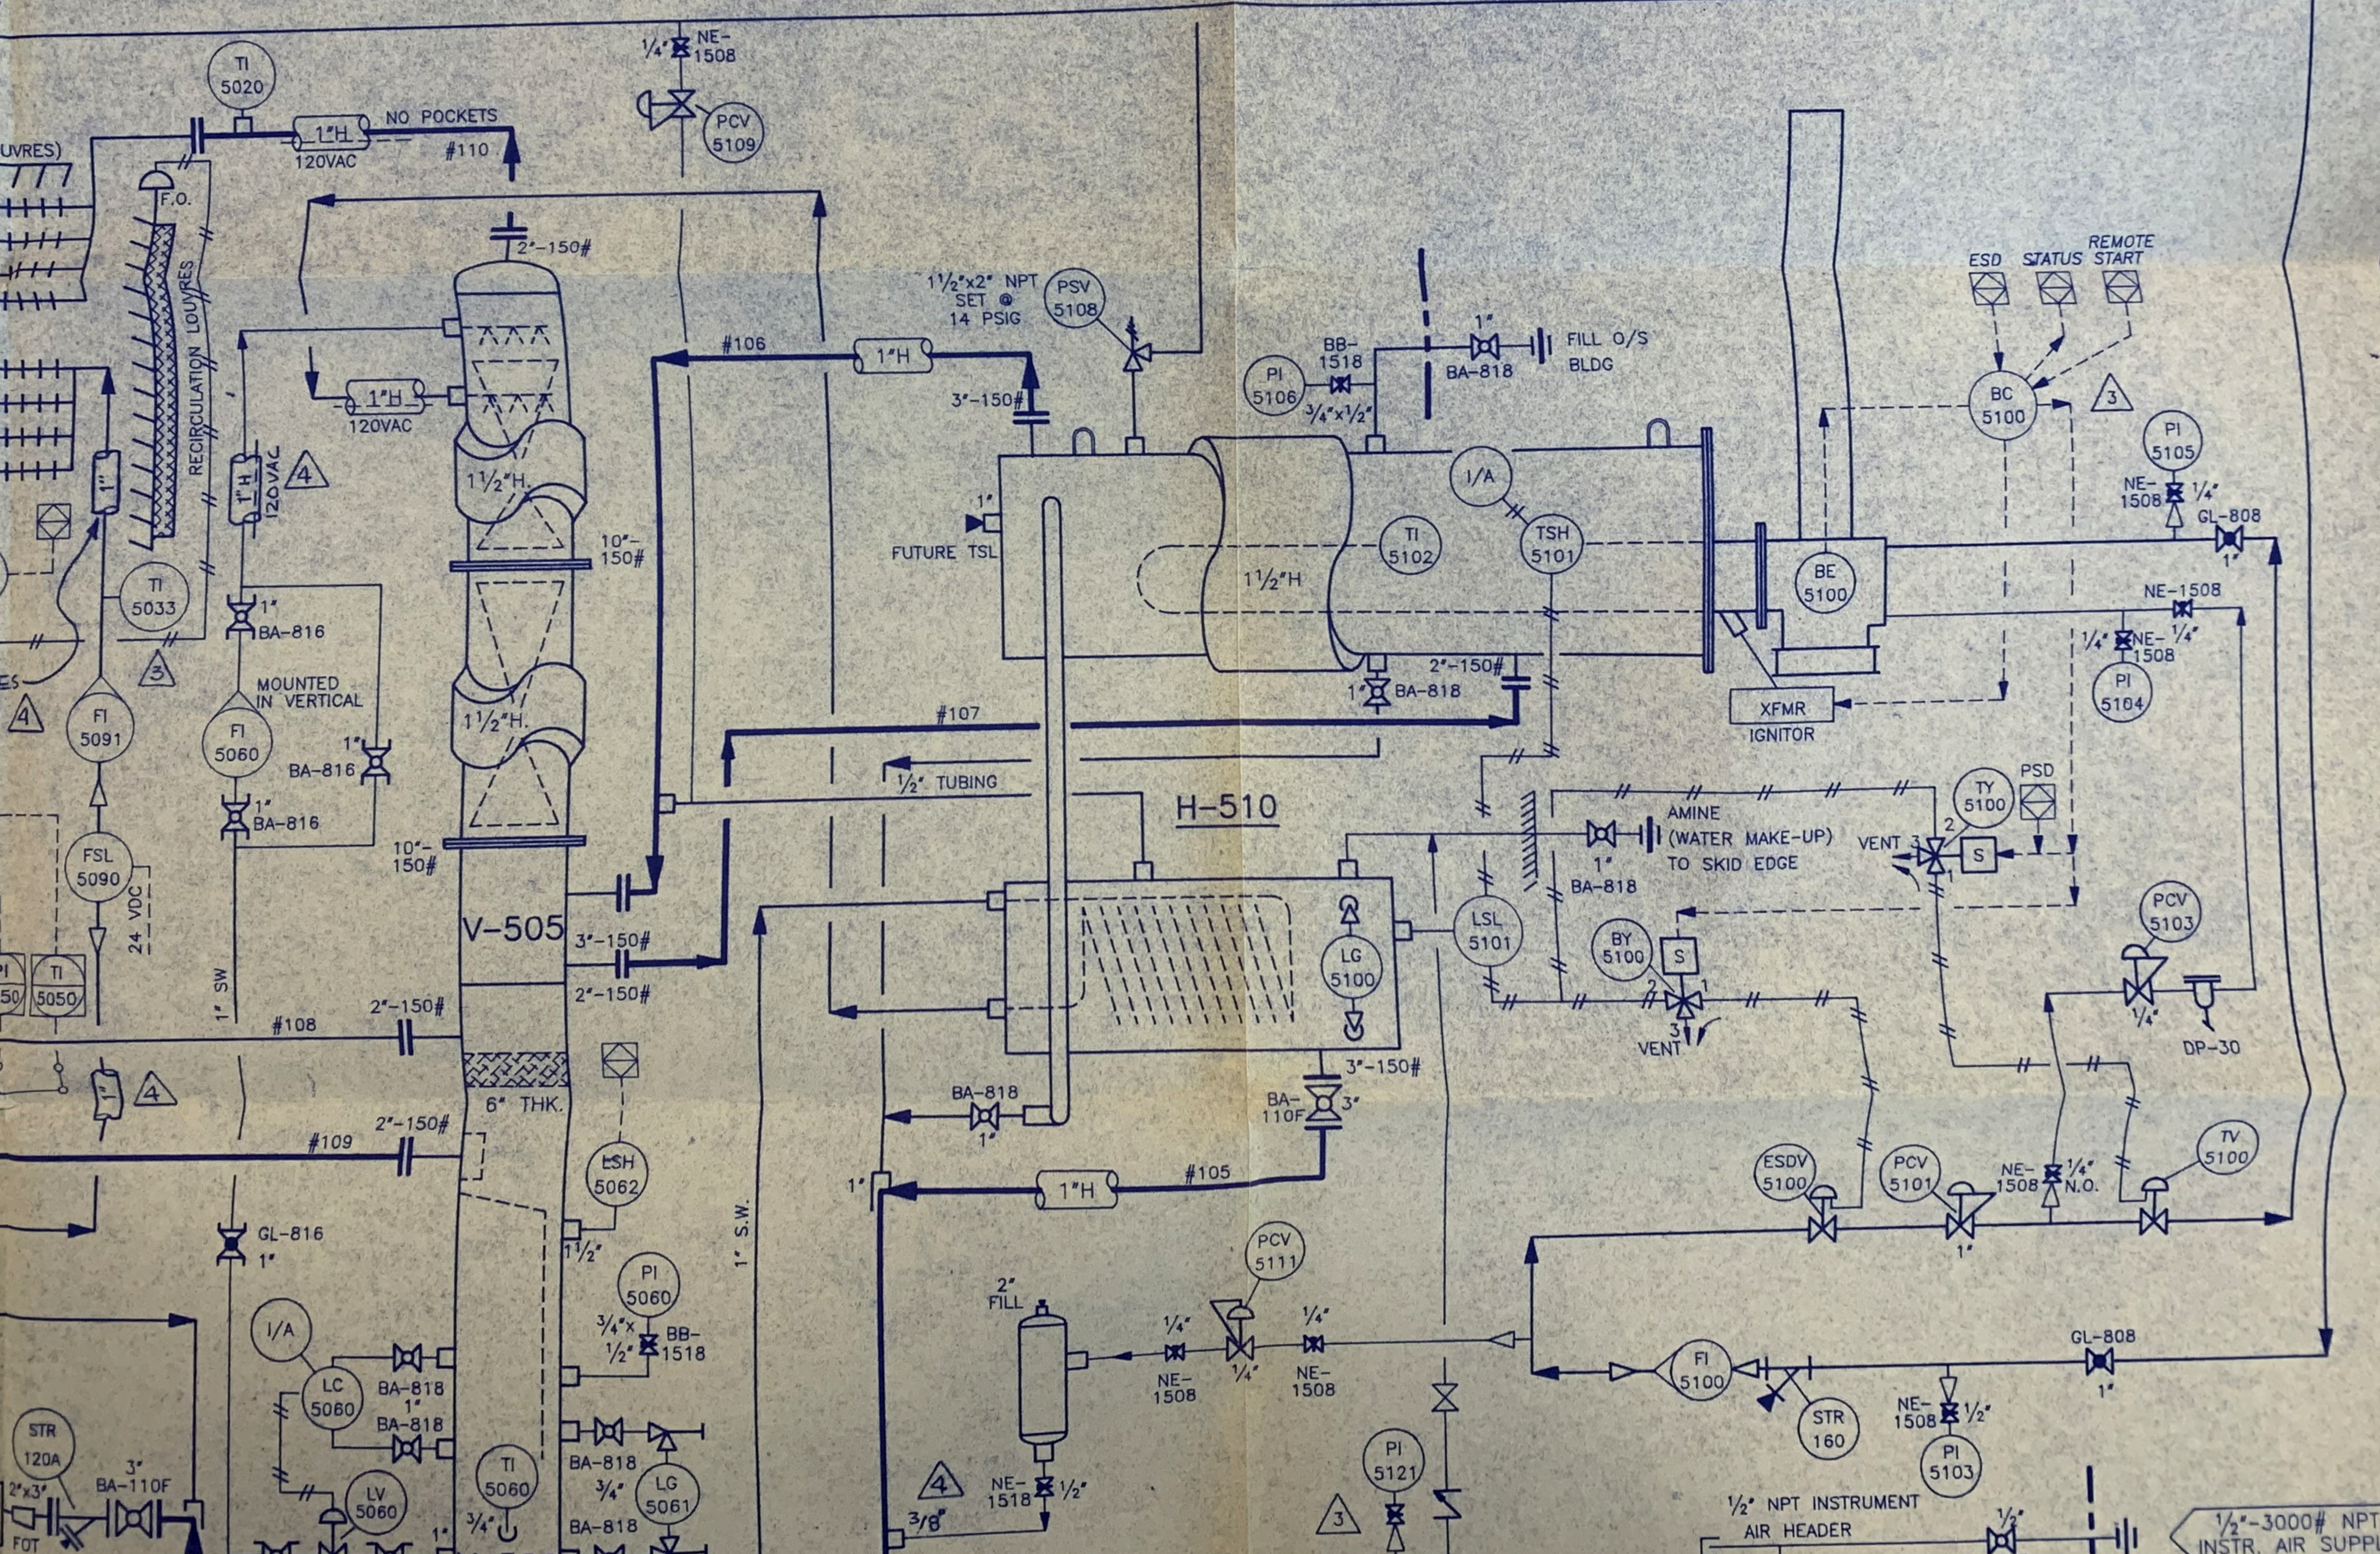

1/2" NPT INSTRUMENT  
AIR HEADER

1/2"-3000# NPT  
INSTR. AIR SUPPLY  
80 PSIG

 

**VALVE TAGGING**

VALVE TYPES: BA=BALL, GA=GATE, GL=GLOBE, CH=CHECK, NE=NEEDLE, BB=NEEDLE (BLOCK w/BLEED)

END CONNECTIONS: 0 = RFF, 1 = RTJ, 6 = SW, 7 = NPT x SW, 8 = NPT

TRIM: 0 = STANDARD, 1 = SOUR

SUFFIX: F = FULL PORT, S = SWING CHECK, P = PISTON CHECK

PRESSURE RATINGS: 1 = 150# ANSI, 3 = 300# ANSI, 6 = 600# ANSI, 8 = 800# API, 9 = 900# ANSI, 15 = 1500# ANSI/1500# API

VALVE TYPE: BA-818

SUFFIX: SUFFIX

END CONNECTION: END CONNECTION

TRIM: TRIM

PRESSURE RATING: PRESSURE RATING

REV.	DATE	BY	APP'D BY	DESCRIPTION		
4	AUG. 14/96	KRT		AS BUILT		
3	JULY 05/96	KRT		GENERAL REVISIONS AS PER APPROVAL DRAWINGS		
2	96-08-13	GDB	B.J.	ISSUED FOR CONSTRUCTION		
1	96-05-27	GDB		ISSUED FOR CONSTRUCTION		
A-20348		LAYOUT/ASSEMBLY	JF	ISSUED FOR APPROVAL		
DWG.		DESCRIPTION	REV. DATE	REV. BY	APP'D BY	DESCRIPTION
		REFERENCE DRAWINGS				REVISIONS

**MECHANICAL FLOWSHEET**  
**AMINE SWEETENING FACILITY**  
 LOCATION: BULRUSH LSD.: c-53-F/94-A-16

DRAWN: JF  
 DATE: 96-04-26  
 SCALE: N.T.S.  
 CHK'D: KEW  
 APP'D: B.J.


CUSTOMER: MORRISON PETROLEUMS LTD. % TARTAN ENGINEERING

The information contained herein is the confidential property of Alco Gas and Oil Production Equipment Ltd., and is not for publication. The information is issued on the understanding that no part thereof shall be copied or communicated to a third party without authorization in writing from Alco Gas and Oil Production Equipment Ltd.

SHOP ORDER: 96c-5544-50  
 REVISION: 4  
 DWG: A-20347

**ALCO** GAS AND OIL PRODUCTION EQUIPMENT LTD

A-17040

 

A-20348	LAY
DWG.	
REFERENCE	