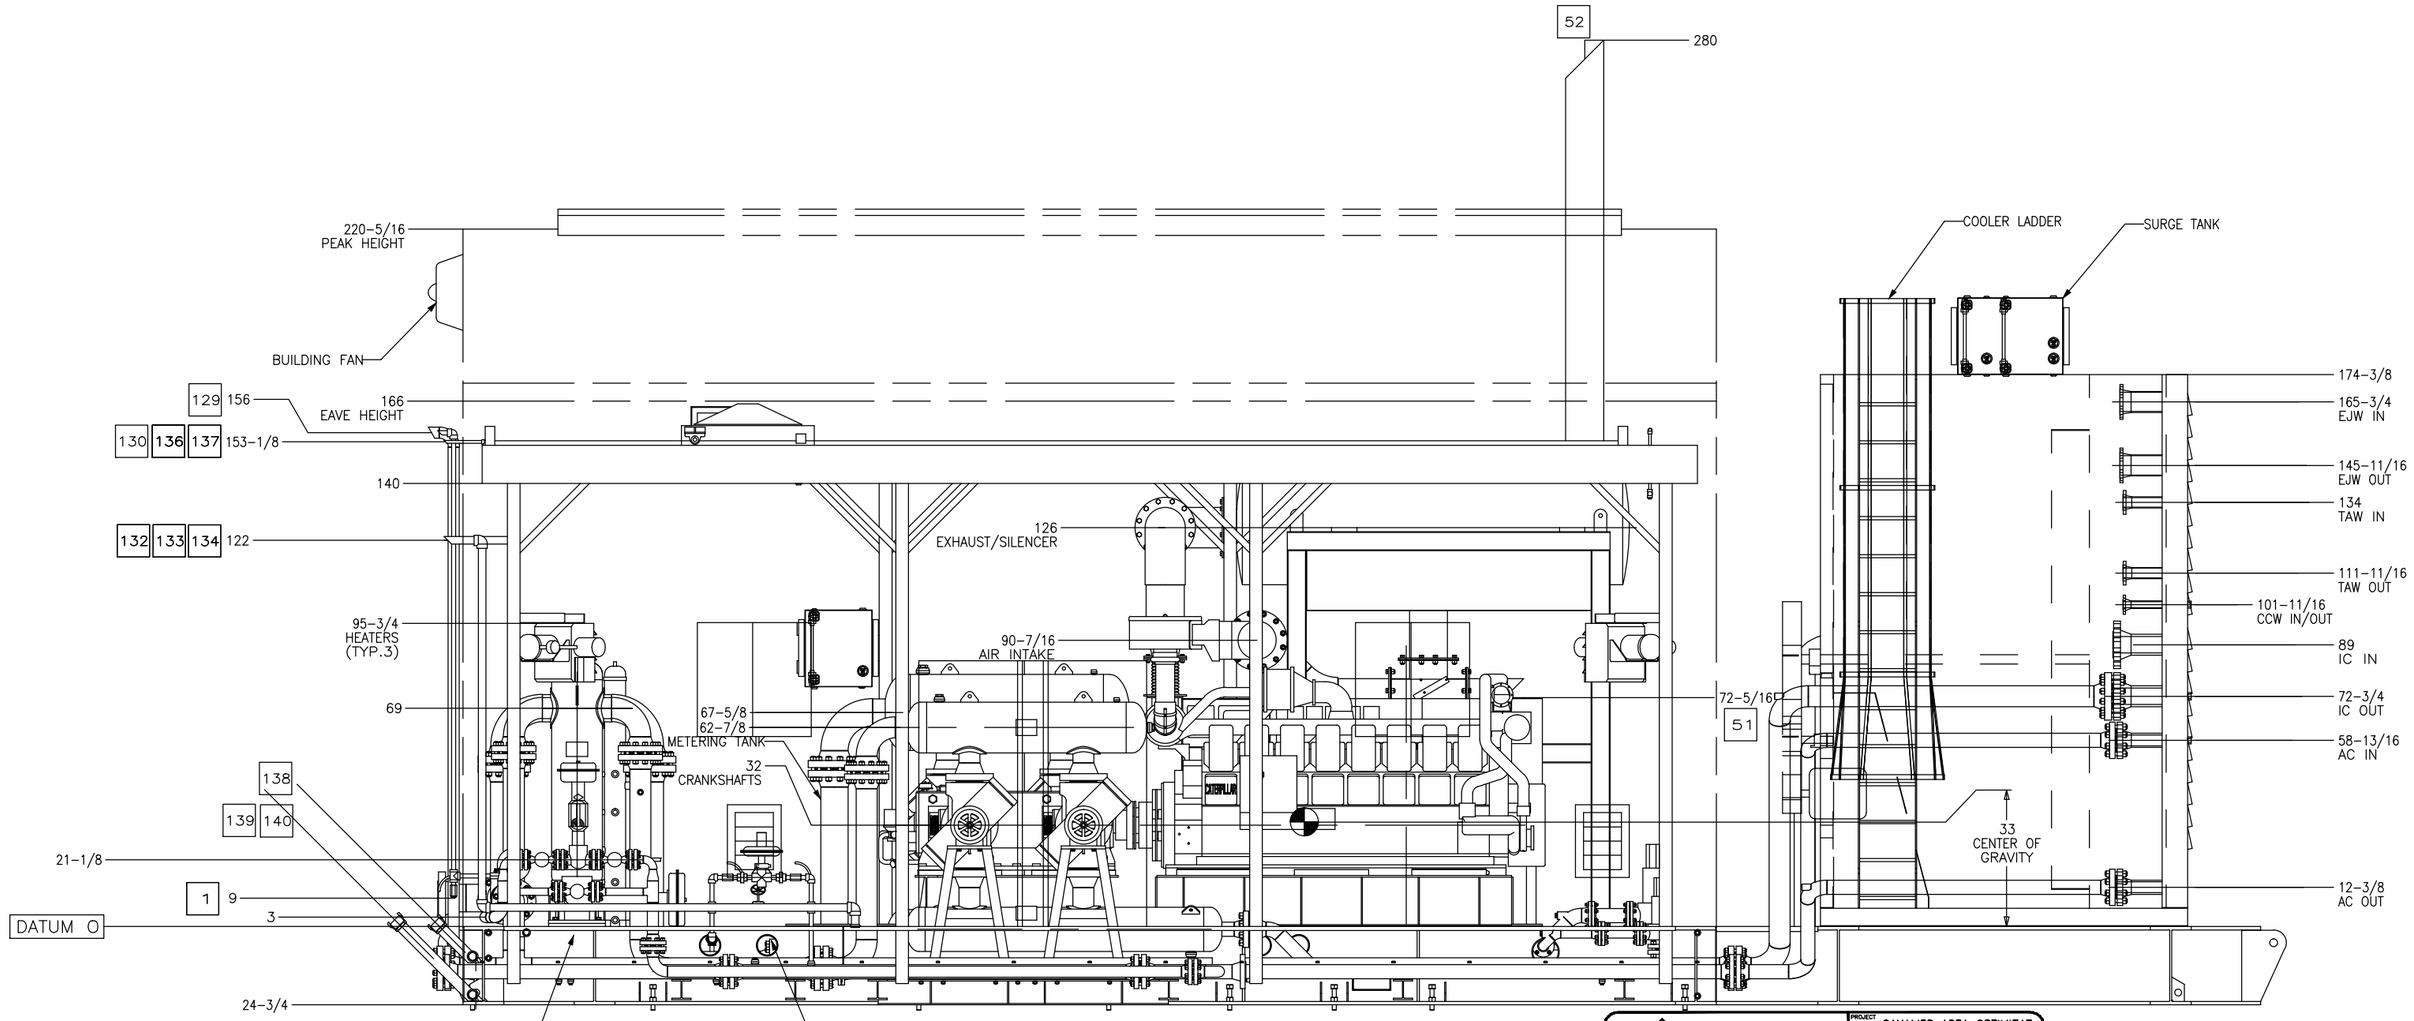

PanCanadian

PROJECT	CAVALIER AREA OPTIMIZAT. ROCKYFORD COMPRESSOR
MAIN FAC.	GAS SAT. 14-09
MAIN LSD.	14-09-025-23 W4M
EPCM.CO	DPH ENGINEERING INC.
EPCMJOB	4330
SITE	GAS PLANT
SITE LSD.	-
EQUIP.	Q-102
TITLE	GENERAL ARRANGEMENT COMPRESSOR PACKAGE (Q-102)
AREA	ROCKYFORD
FILE NO.	RK00834Q

FILE: .....

THIS DRAWING REPRESENTS PROPRIETARY INFORMATION AND SHOULD NOT BE DISTRIBUTED OR MODIFIED IN ANY MANNER THAT IS NOT IN THE BEST INTEREST OF PANCANADIAN OR THE ORIGINAL AUTHOR

November 27, 2001 8:27:43 a.m.
Drawing: Q:\PCPJOBS\4330\VENDOR\WEATHERFORD\RK00834Q.DWG

CUSTOMER CONNECTIONS

TAG	DESCRIPTION	SIZE	TAG	DESCRIPTION	SIZE
	SEE SHEET 1 OF 3 FOR CONNECTIONS				

ESTIMATED WEIGHTS

DESCRIPTION	SHIPPING ARRANGEMENT	WEIGHT (lb)
COMPRESSOR	MOUNTED	
DRIVER	MOUNTED	
COOLER	MOUNTED	
SKID	MOUNTED	
VESSEL	MOUNTED	
EXHAUST SYSTEM	MOUNTED/S. LOOSE	
MISC.	MOUNTED/S. LOOSE	
CRANE	MOUNTED	
BUILDING	MOUNTED	
TOTAL APPROX. SHIPPING WEIGHT		
TOTAL APPROX. WEIGHT OF ALL EQUIPMENT	SEE SHEET 1 OF 3 FOR WEIGHTS	

OVERALL DIMENSIONS

DESCRIPTION	LENGTH FT-IN [mm]	WIDTH FT-IN [mm]	HEIGHT FT-IN [mm]
SHIPPING	-	-	-
OVERALL	-	-	-

GENERAL NOTES

1. SEE SHEET 1 OF 3 FOR GENERAL NOTES

STAMP AREA

REV.	BY	CHK'D	ECR No. or REVISION DESCRIPTION	DATE
2	KLL		AS-BUILT - DPH PROJECT # 4330	01.04.13
			SEE SHEET 1 OF 3 FOR REVISION	

Weatherford GLOBAL

Weatherford Global Compression Services
4949 - 76th Avenue S.E.
P.O. Box 5308, Station A
Calgary, Alberta, Canada T2H 1X6

403/236-5252 Main
800/661-5252 Toll Free
403/236-4261 Fax

TITLE: GENERAL ARRANGEMENT
SUPERIOR RAM-54, CATERPILLAR 3516-LE-AFRC, AMERCOOL 156VCIB
NATURAL GAS COMPRESSOR PACKAGE

END USER/CONSULTANT: PANCANADIAN RESOURCES			CUST. P.O. No.: -
LOCATION: 2000 STOCK TBA			REVISION: 1
			DWG. REFERENCE: -
DRAWN:	K. CHAN	W.O. No.: 003144	
DATE:	04 MAY 00	UNIT No.: 003144	DWG. No.: 003144-D-2
CHK'D:	J. KASZAS	No.REQ'D: ONE PER WO	(SHEET 2 OF 3)
PRJ.LDR.:	J.KASZAS	SCALE: 27:640	