THE SIGNATURE AND SEAL OF THE UNDERSIGNED ON THIS DRAWING CERTIFIES THAT THE DESIGN INFORMATION CONTAINED IN THESE DRAWINGS ACCURATELY REFLECTS THE ORIGINAL DESIGN AND THE MATERIAL DESIGN CHANGES MADE DURING CONSTRUCTION, THAT WERE BROUGHT TO THE UNDERSIGNED'S ATTENTION. THESE DRAWINGS ARE INTENDED TO INCORPORATE ADDENDA, CHANGE ORDERS AND OTHER MATERIAL DESIGN CHANGES, BUT NOT NECESSARILY ALL SITE INSTRUCTIONS.

THE UNDERSIGNED DOES NOT WARRANT OR GUARANTEE, NOR ACCEPT ANY RESPONSIBILITY FOR THE ACCURACY OR COMPLETENESS OF THE AS-CONSTRUCTED INFORMATION SUPPLIED BY OTHERS CONTAINED IN THESE DRAWINGS, BUT DOES CERTIFY THAT THE AS-CONSTRUCTED INFORMATION, IF ACCURATE AND COMPLETE, PROVIDES AN AS-CONSTRUCTED SYSTEM WHICH SUBSTANTIALLY COMPLIES IN ALL MATERIAL RESPECTS WITH THE ORIGINAL DESIGN INTENT.

TEAL A1 SIZE TITLEBLOCK V.2

PLOTTED DATE: 6/6/2011 5:04:24 PM BY: TODD.DREBIT

LAST SAVED DATE: 6/6/2011 4:34:49 PM BY: TODD.DREBIT

H:\DRAFTING\CLIENTS\APACHE\PATRY\01(C-11-J-94-O-5) - CENTRAL DEHY\PID\PAD1M15.DWG

P-702
KNOCK-OUT LIQUIDS PUMP
MYERS MV2-70(S)
CAPACITY: 2.3m³/hr.
MOTOR: 0.55 kW

BH-700
BUILDING HEATER
CATADYNE HEATER

V-700
KNOCK-OUT DRUM
DESIGN PRESSURE: 345 kPag
SIZE: 1829mm O.D. x 5486mm S/S
CAPACITY: 100bbl
REGISTERED VESSEL
M.A.W.P.: 14.9 psig

FL-700
FLARE STACK
324mm (12") x 25908mm (85'-0") HIGH
c/w GUY-WIRES

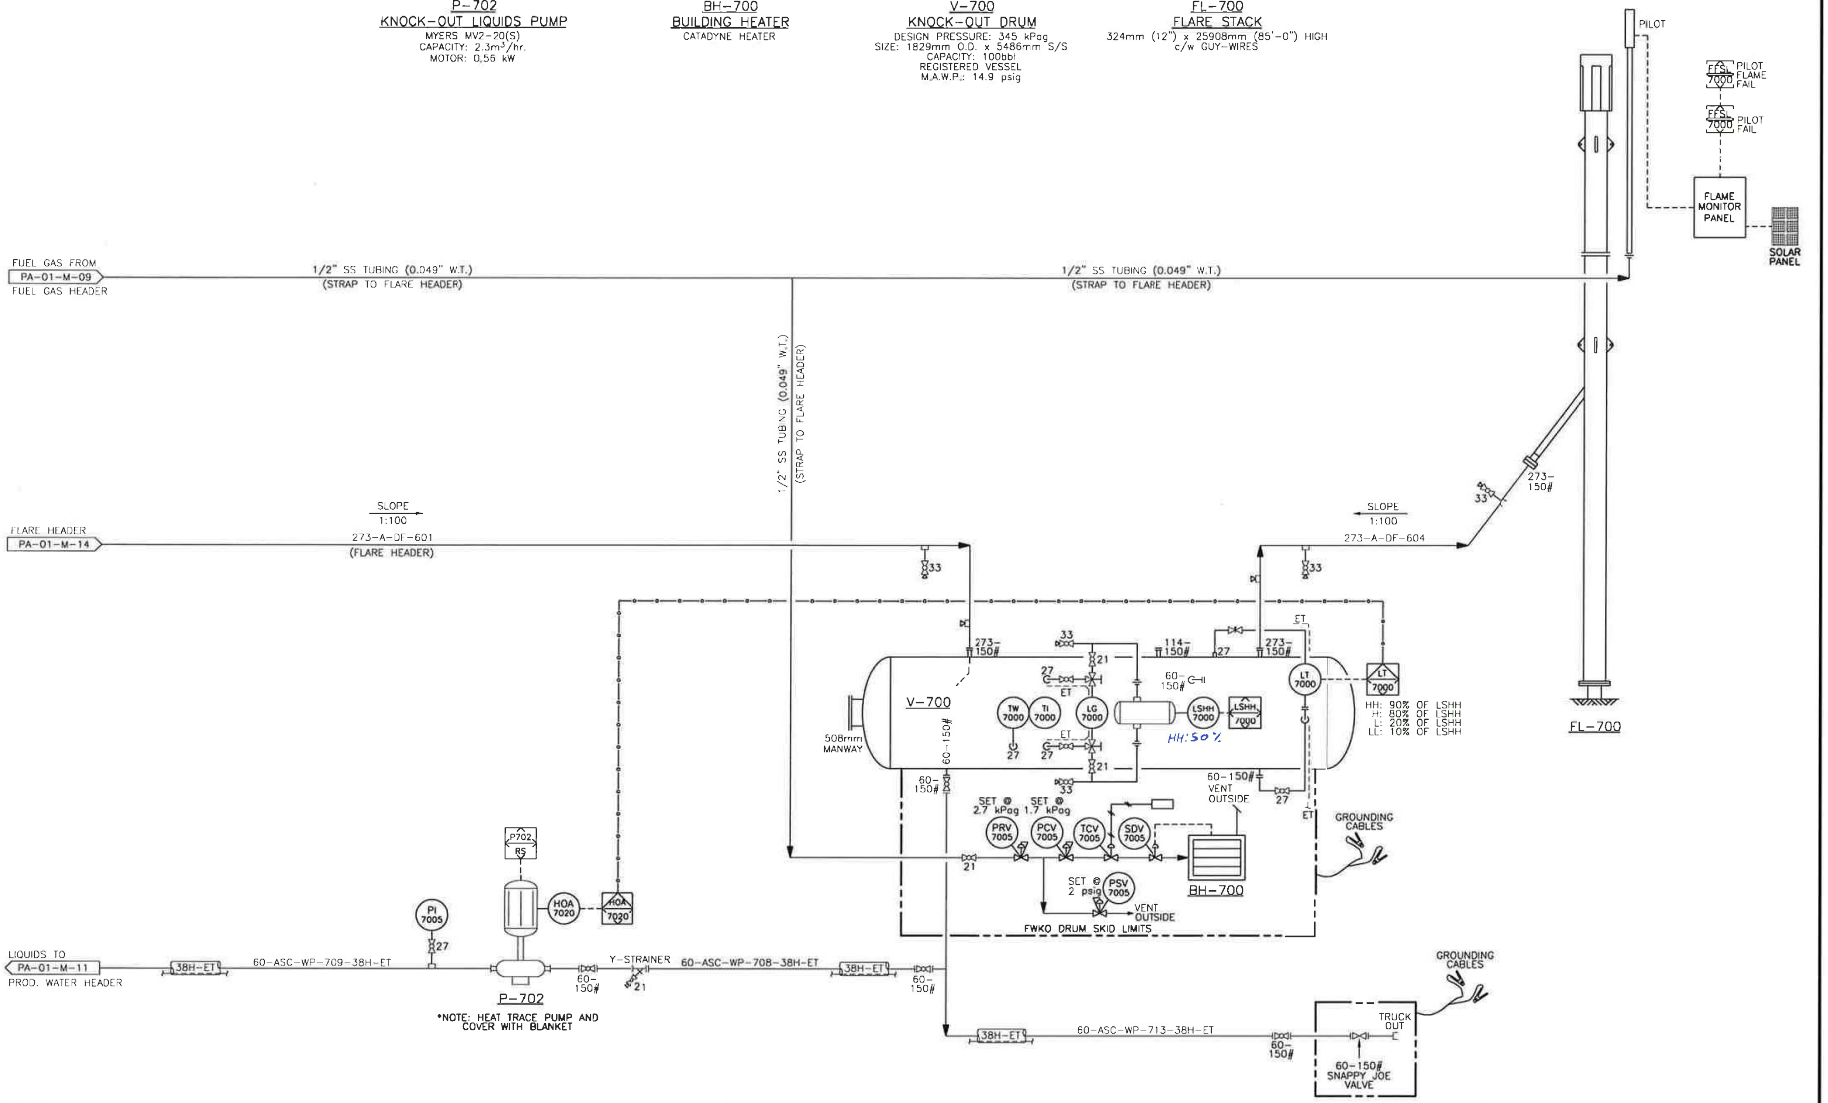

REFERENCE DWG. NO.	REFERENCE DRAWINGS	REV.	REVISION DESCRIPTION	PROJ NO.	BY	DATE	CHD	APPD
T2091-900	NUSCO MANUFACTURING & SUPPLY LTD. (KNOCK-OUT DRUM)	A	ISSUED FOR OGC APPROVAL	100-10-005	FH	10.09.17	.	.
03-D-2086	PYRAMID CORPORATION (FLARE STACK)	B	ISSUED FOR BID	100-10-005	PO	10.11.15	BW	FdC
.	.	0	ISSUED FOR CONSTRUCTION	100-10-005	TD	10.12.16	BW	FDC
.	.	1	AS BUILT	100-10-005	TD	11.05.06	TD	FDC
.	.	.	.	.	.	.	.	.
.	.	.	.	.	.	.	.	.
.	.	.	.	.	.	.	.	.
.	.	.	.	.	.	.	.	.
.	.	.	.	.	.	.	.	.

ENGINEER'S STAMP

PROFESSIONAL ENGINEER PROVINCE OF ALBERTA F.De CAIGNY #31792 BRITISH COLUMBIA ENGINEER
June 7/2011

PERMIT STAMP

PPMP
GENIVAR INC.
Signature
Date June 22/11

ENGINEER AND PERMIT STAMPS APPLY TO AREAS OUTSIDE SKID LIMITS AND CLOUDED AREAS ONLY

GENIVAR
805 - 1331 MACLEOD TRAIL SE
CALGARY (ALBERTA)
CANADA T2G 0K3
PHONE: 403 777-2477 FAX: 403 777 2419
WWW.GENIVAR.COM

Apache CANADA LTD

PATRY - CENTRAL DEHY.
c-11-J/94-O-5
KNOCK-OUT DRUM (V-700) & FLARE STACK (FL-700)
PIPING & INSTRUMENTATION DIAGRAM

DRAWN BY	DATE CREATED	SCALE	DRAWING NUMBER	REV.
T. DREBIT	2010-09-01	N.T.S.	A1-PA-01-M-15	1