TK-250
DRAIN TANK
NO INFORMATION

BH-230
BUILDING HEATER
RUFFNECK
FX5
POWER: 10kW
HZ: 60, 3ϕ
VOLTS: 600
AMPS: 9.5

V-210
FUEL GAS SCRUBBER
NATCO CANADA LTD.
MAWP: 1334 kPa @ 93°C/-29°C
S/N: 21-41863R
CRN: N-3019.21

V-200
FREE WATER KNOCKOUT
SERVAL PROCESS INDUSTRIES
MAWP: 517 kPa @ 93°C
S/N: 99-1354-1
CRN: L-1091.2
AF 442342

F-220
WATER FILTER
NO INFORMATION

BF-240
BUILDING FAN
NO INFORMATION

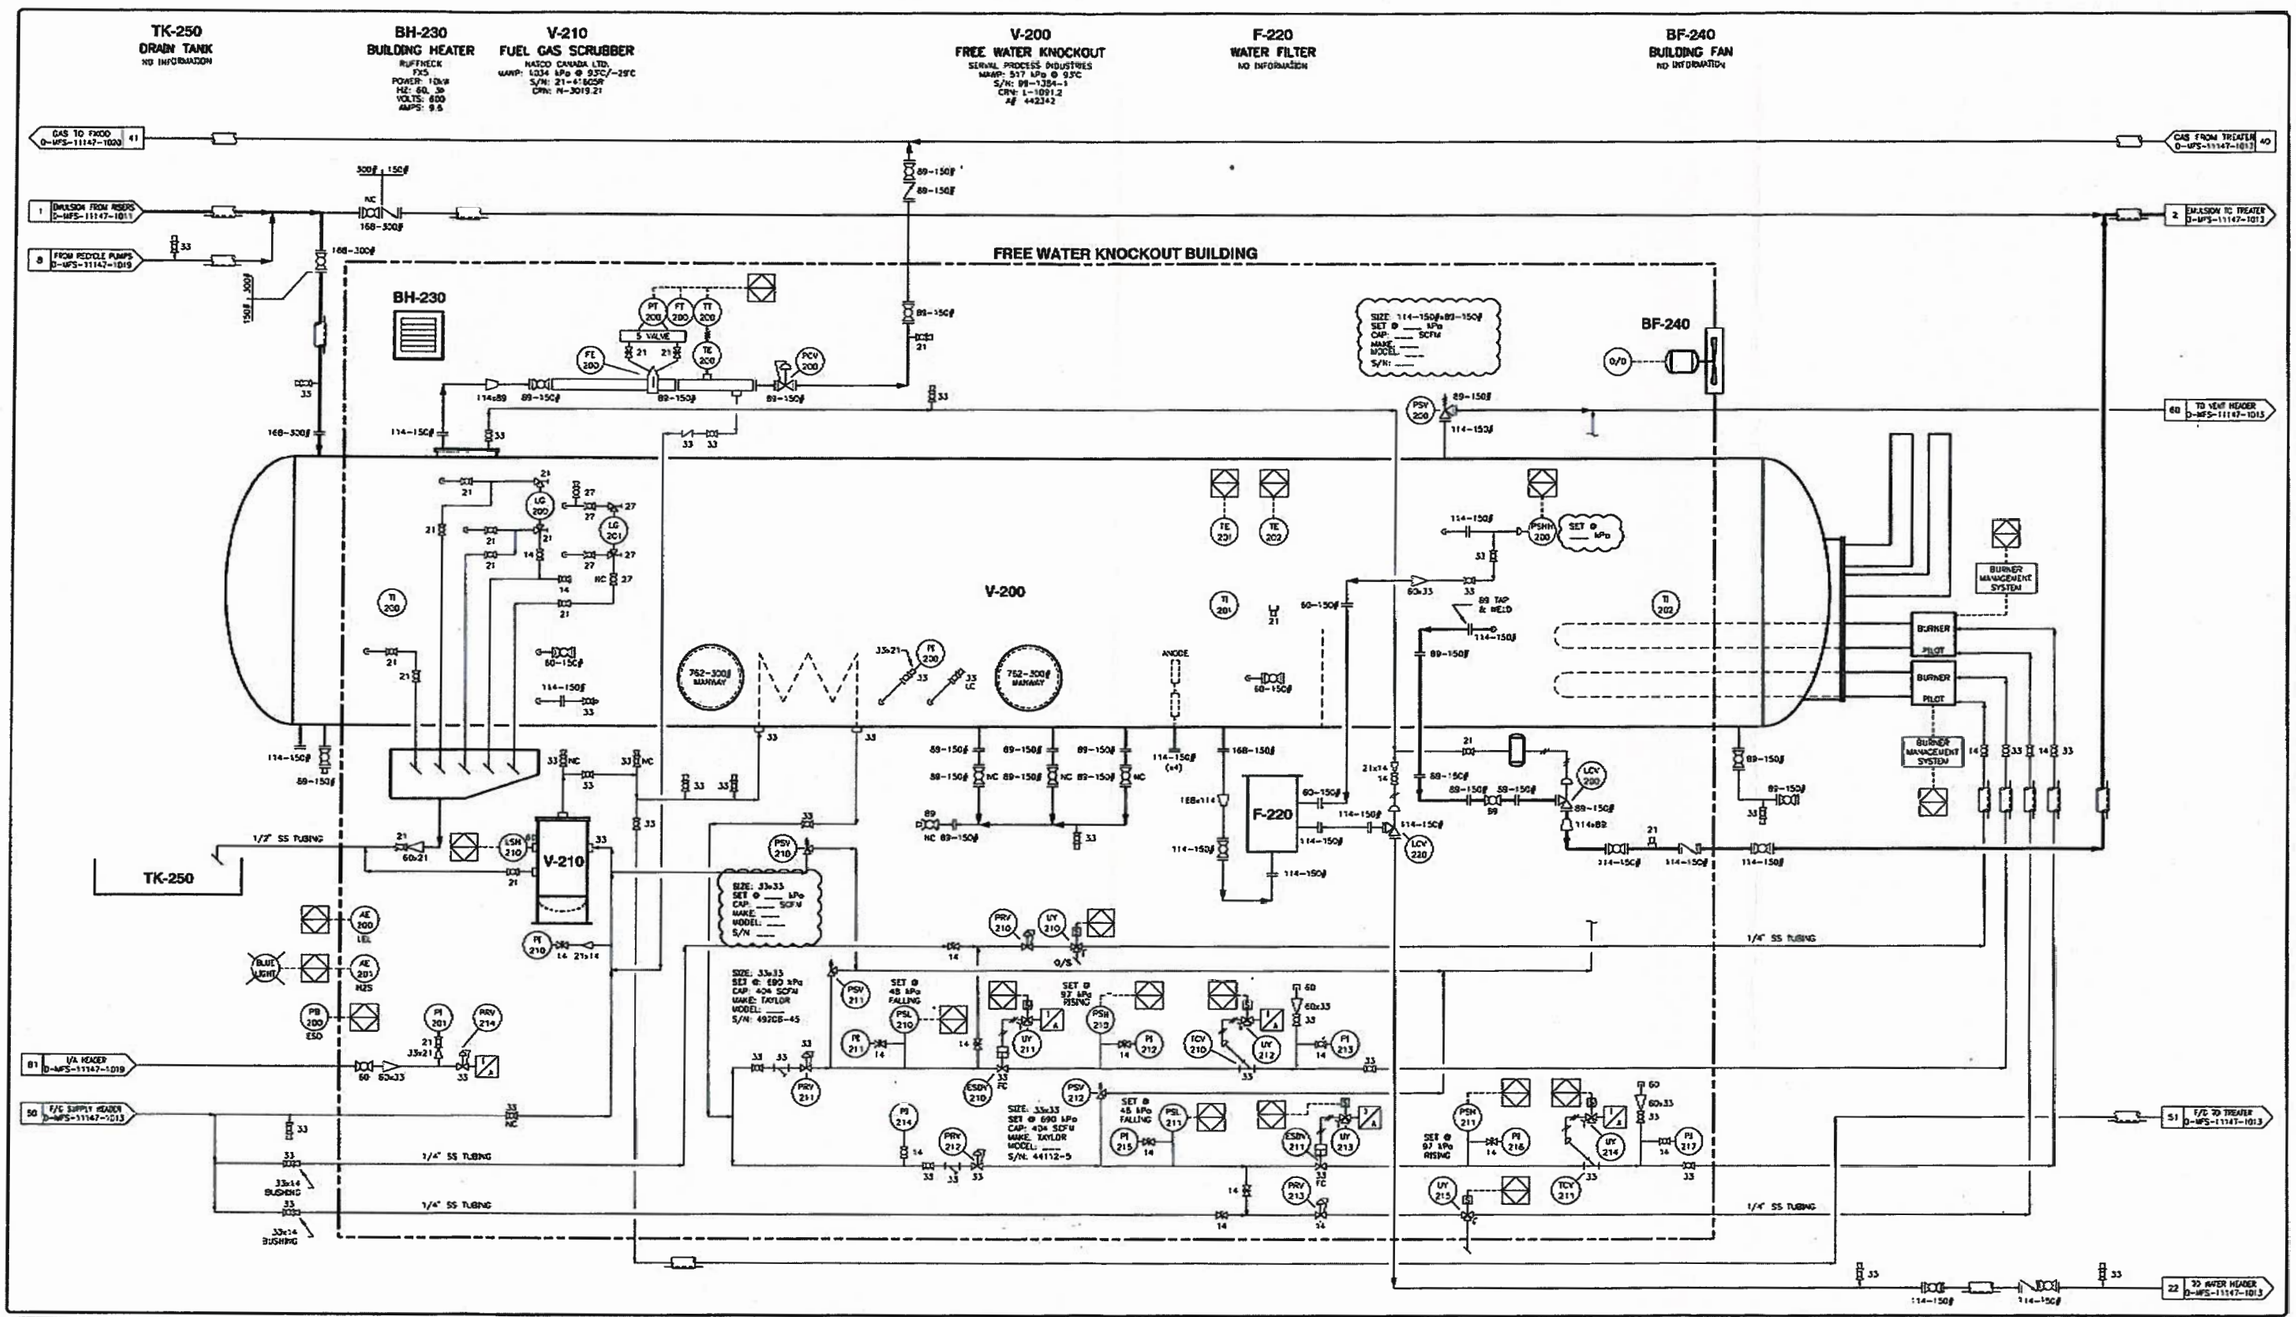

NOTE:
1. "---" OR CLOUDS INDICATE INFORMATION GAS LIQUIDS ENG. AND OPERATIONS WERE UNABLE TO OBTAIN
2. SPEC BREAKS DENOTE OPERATING CONDITIONS ONLY. PIPE MAY IN SOME CASES BE DESIGNED TO HIGHER OR LOWER PRESSURE SPECIFICATION THAN ACTUAL OPERATING CONDITIONS.
3. LINE NUMBERS ARE AS PER ORIGINAL FACILITY DRAWINGS

XREF 11147PID-MSTR1.DWG
Q:\11147\D-MFS-11147-1012.DWG
PLOTTED: SEP 22, 2011 2:24 PM

No.	Revision	By	Date	Chk.	E.Chk	E.App	Client
0	AS-BUILT	STK	11-16-14	MBG			

Stamps

Engineering Record		
RFE		
Client		
Approved		
Eng. Check		
Date		
Eng. By		
	IFC	AB

GAS LIQUIDS ENGINEERING

WASKADA 15-09 BATTERY

PROCESS & INSTRUMENTATION DIAGRAM FREE WATER KNOCKOUT BUILDING LSD 15-09-002-25 W1M

Scale	Size	Drawing Number	Rev.
NONE	B	D-MFS-11147-1012	0