THE INFORMATION CONTAINED HEREIN IS THE CONFIDENTIAL PROPERTY OF TOROMONT PROCESS SYSTEMS AND IS NOT FOR PUBLICATION, AND NO PART THEREOF SHALL BE COPIED OR COMMUNICATED TO A THIRD PARTY WITHOUT AUTHORIZATION FROM TOROMONT PROCESS SYSTEMS.

C-1
GAS COMPRESSOR
FRICK: TDSH-283SX
OPERATING SPEED: 1800 RPM
SUCTION PRESSURE: SEE CURVE
DISCHARGE PRESSURE: SEE CURVE
OIL TEMPERATURE: 160 DEG.F
POWER DRAW: SEE CURVE
WEIGHT: 4700 LBS.

F-1
OIL FILTER
SIZE: 8.6" O.D. X 27.5" S/F
MAWP: 400 PSIG @ 250 DEG.F
MDMT: -20 DEG.F @ 400 PSIG
CA: 0.0625"
SHELL MATERIAL: SA-106B
HEAD MATERIAL: SA-516-70
ELEMENT: (1) MODEL 1833C
WEIGHT: 286 LBS.

V-2
OIL SEPARATOR
SIZE: 36" I.D. X 102" S/S
MAWP: 350 PSIG @ 250 DEG.F
MDMT: -20 DEG.F @ 350 PSIG
CA: 0.0625"
SHELL MATERIAL: SA-516-70
HEAD MATERIAL: SA-516-70
ELEMENT: (5) RSC1175-3
WEIGHT: 4300 LBS.

E-2
OIL COOLER
MODEL: VICARB V-45-SST-100
PLATES: 47
MAWP OIL SIDE: 350 PSIG @ 250 DEG.F
MAWP GLYCOL SIDE: 350 PSIG @ 250 DEG.F
DESIGN DUTY: 988722 BTU/HR
SURFACE AREA: 217.86 SQ.FT
WEIGHT: 2625 LBS.

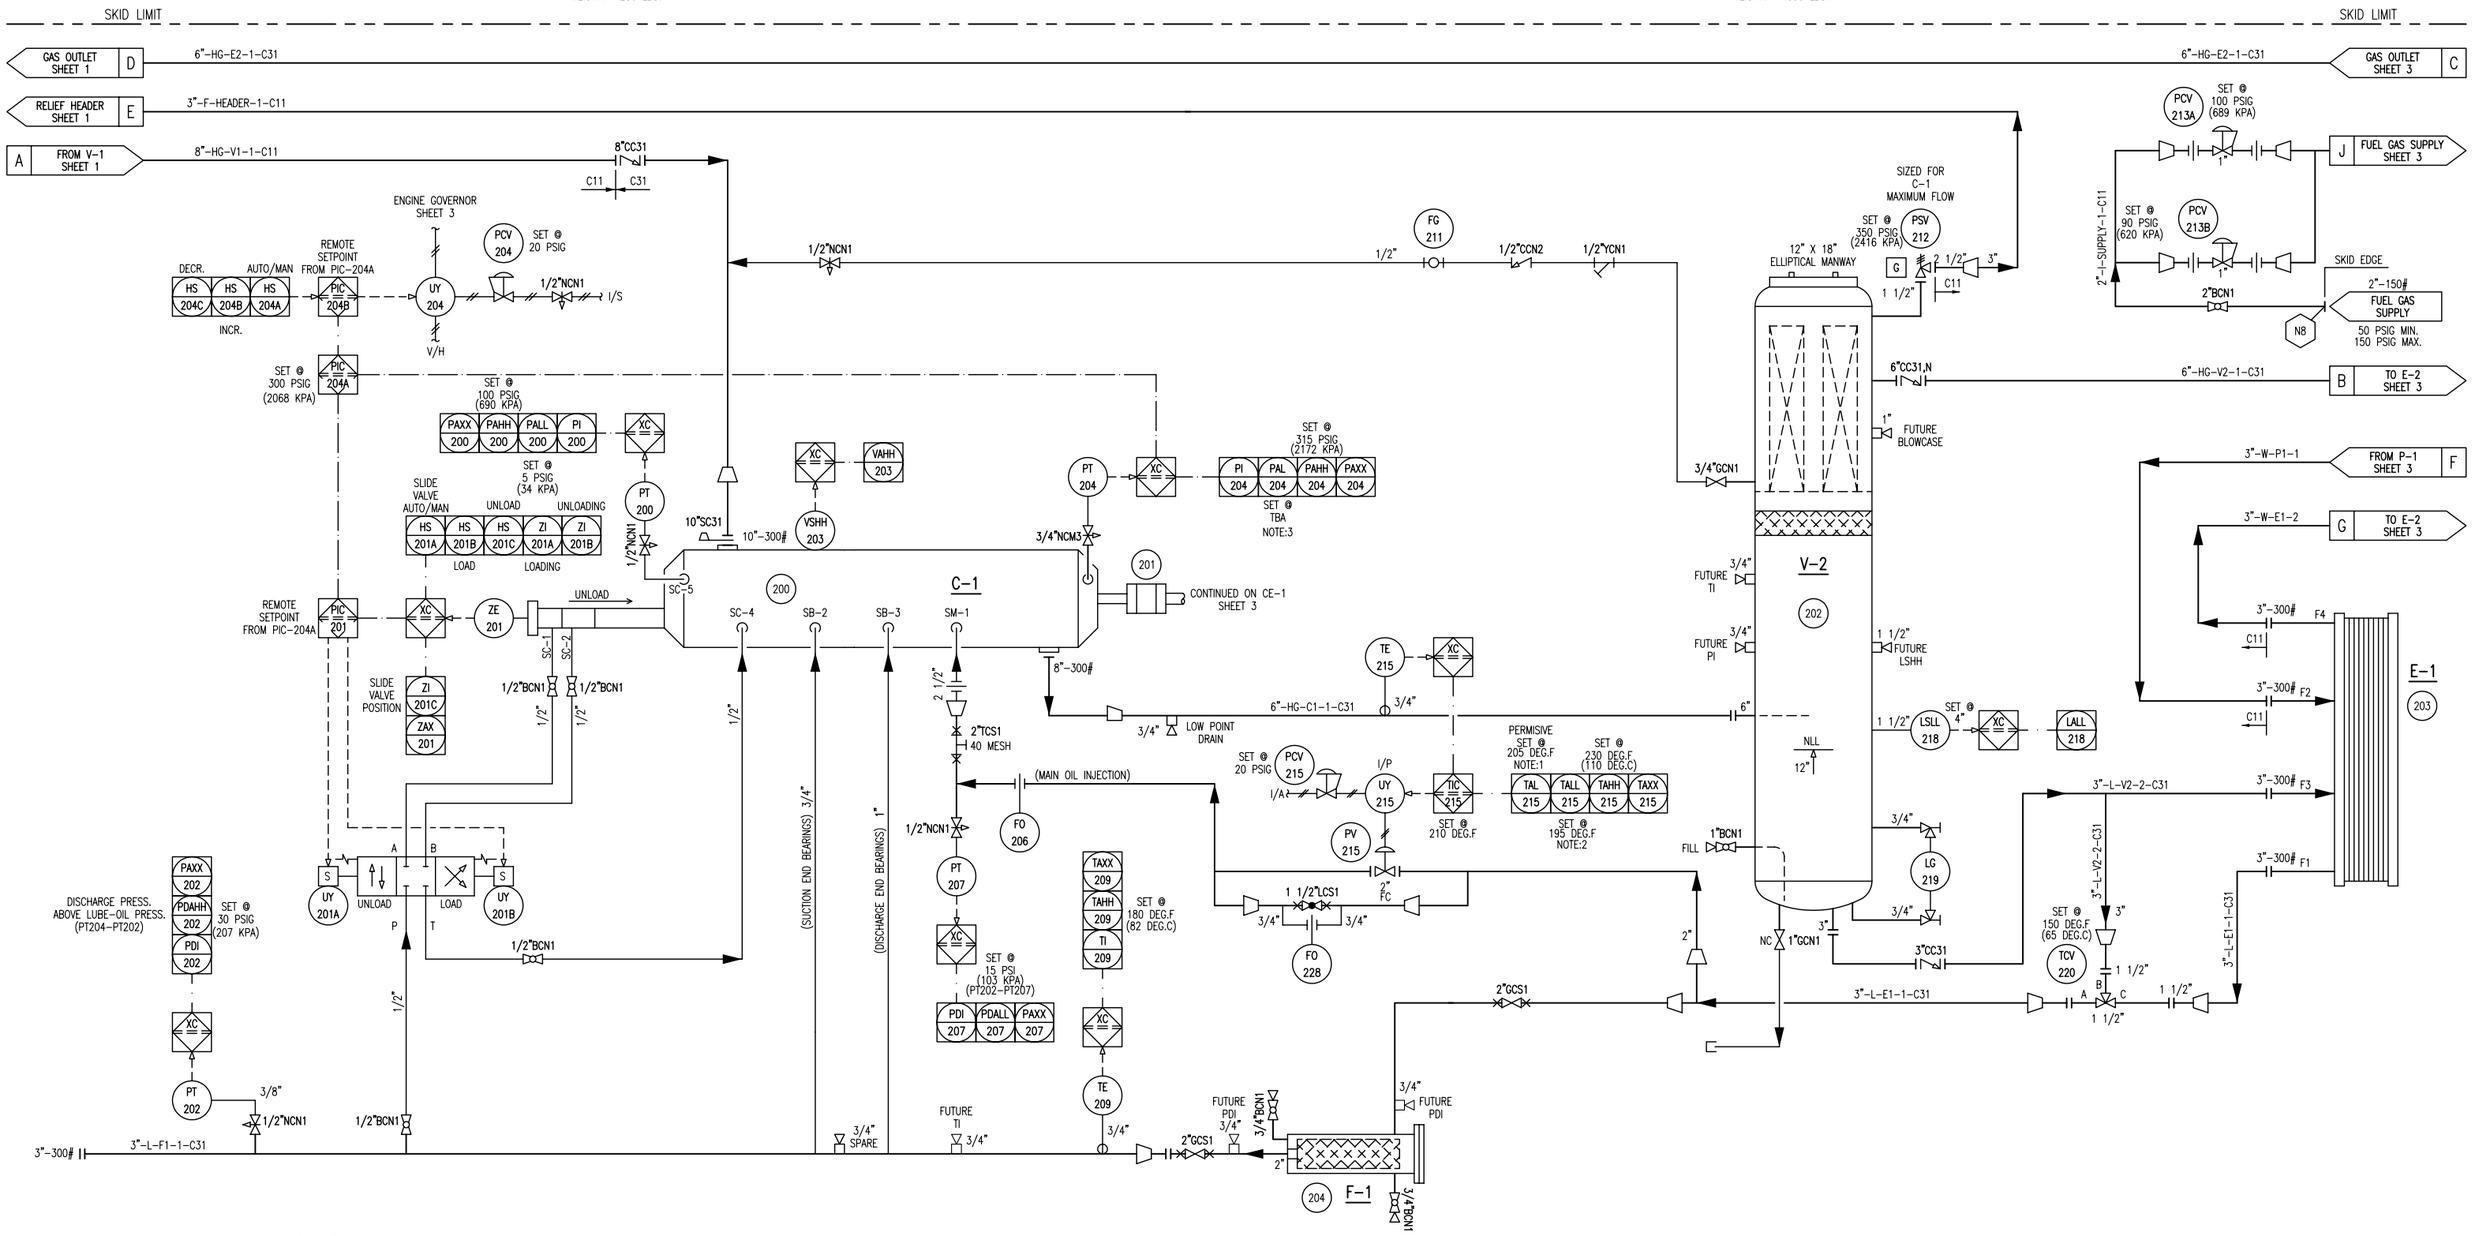

NOTE:1 TAL-215 - PERMISSIVE TO OPEN ESD VALVES AND INTRODUCE RAW GAS.
NOTE:2 TALL-215 - SHUTDOWN TO PREVENT CONDENSATION.
NOTE:3 PAL-204 - PERMISSIVE TO START C-1.
SYSTEM MUST BE PRESSURIZED (WITH SWEET GAS) TO "TBA" PSIG.

NEXT AVAILABLE TAG NUMBER: 229

REV.	DESCRIPTION	DATE	BY	APPR.
2	AS BUILT	NOV.15/01	PN	
1	ISSUED FOR CONSTRUCTION	SEPT.4/01	PN	RC

PERMIT TO PRACTICE STAMP

ENGINEER STAMP

TOROMONT / TOROMONT PROCESS SYSTEMS

TITLE: P & I FLOW DIAGRAM

FOR: ANDERSON EXPLORATION LTD.
600 HP BOOSTER COMPRESSOR
DREAU
LSD: 1-15-78-21 W5M

DRAWN BY: P. NOBLE	DATE: SEPT. 4, 2001
CHKD. BY: R. CALBUREAN	SCALE: N/A
APPR. BY: R. CALBUREAN	W.O. No: 10822101
CUST. PO No:	
DWG. No: 10822-101	SHEET No: 2 OF 4
	REV: 2

TPS DATE: NOV 15, 2001 TIME: 11:27 AM