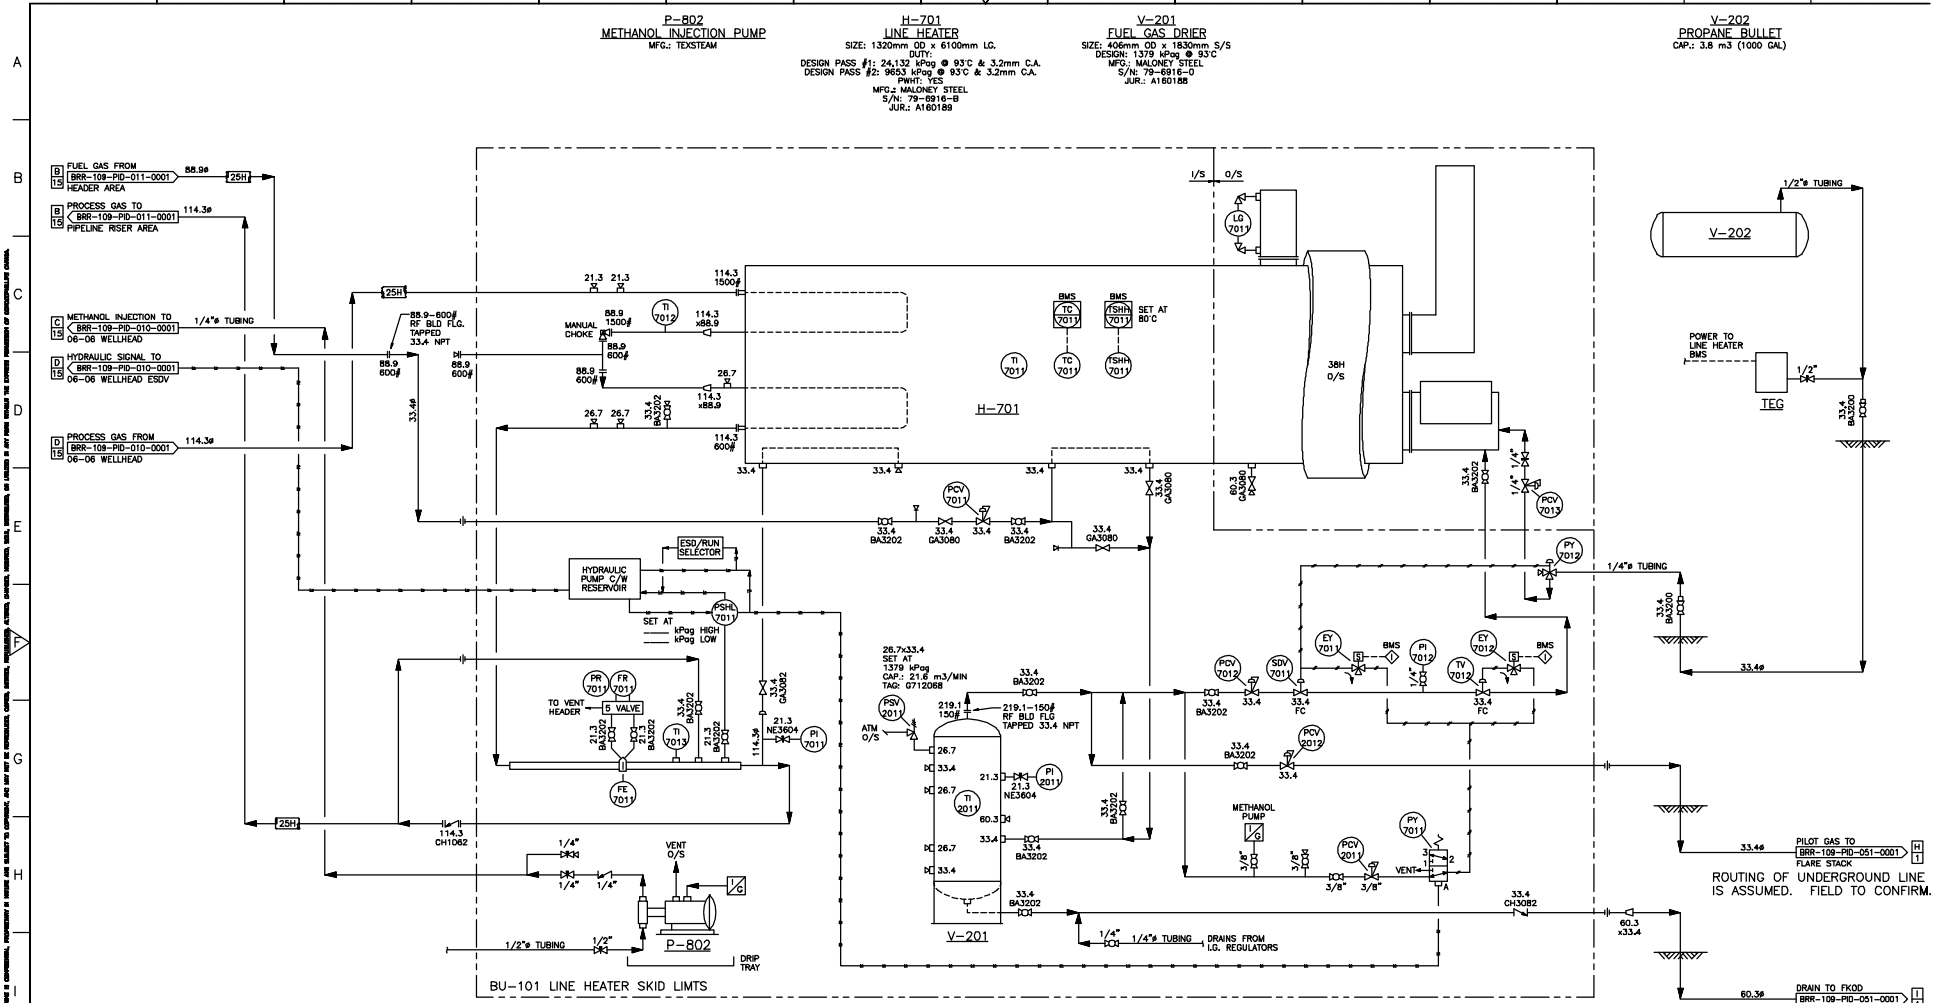

NOTES:

1. "BMS" INDICATES THE LINE HEATER BURNER MANAGEMENT SYSTEM.

REFERENCE DRAWINGS	
DWG No.	TITLE

PROJECT VERSION (Clear cell info prior to returning to CPC)						
VER.	DATE	BY	CHK'D DFTG	CHK'D ENG	APP'D PM	VERSION ISSUE

REVISIONS						
REV.	DATE	BY	CHK'D DFTG	CHK'D ENG	APP'D PM	REVISION ISSUE
0	10/07/08	GF				AS-BUILT AS PER JUNE 2010 SITE VISIT (NETWORK #10281434) (BY CPC)

ENGINEERING SEAL

PREPARED BY ConocoPhillips Canada

PERMIT

ConocoPhillips Canada

BRAZEAU RIVER 06-06 WELLSITE

LINE HEATER AREA

PIPING AND INSTRUMENTATION DIAGRAM

LEGAL DESC. FROM: 06-06-048-12 W5M

LEGAL DESC. TO (IF APPL.

LEGACY DWG NO.:

SCALE: NTS

CPC DWG. NO.: BRR-109-PID-030-0001

REV.: 0

DWG. OR PROJ. NO.:

DATE: 15/07/10

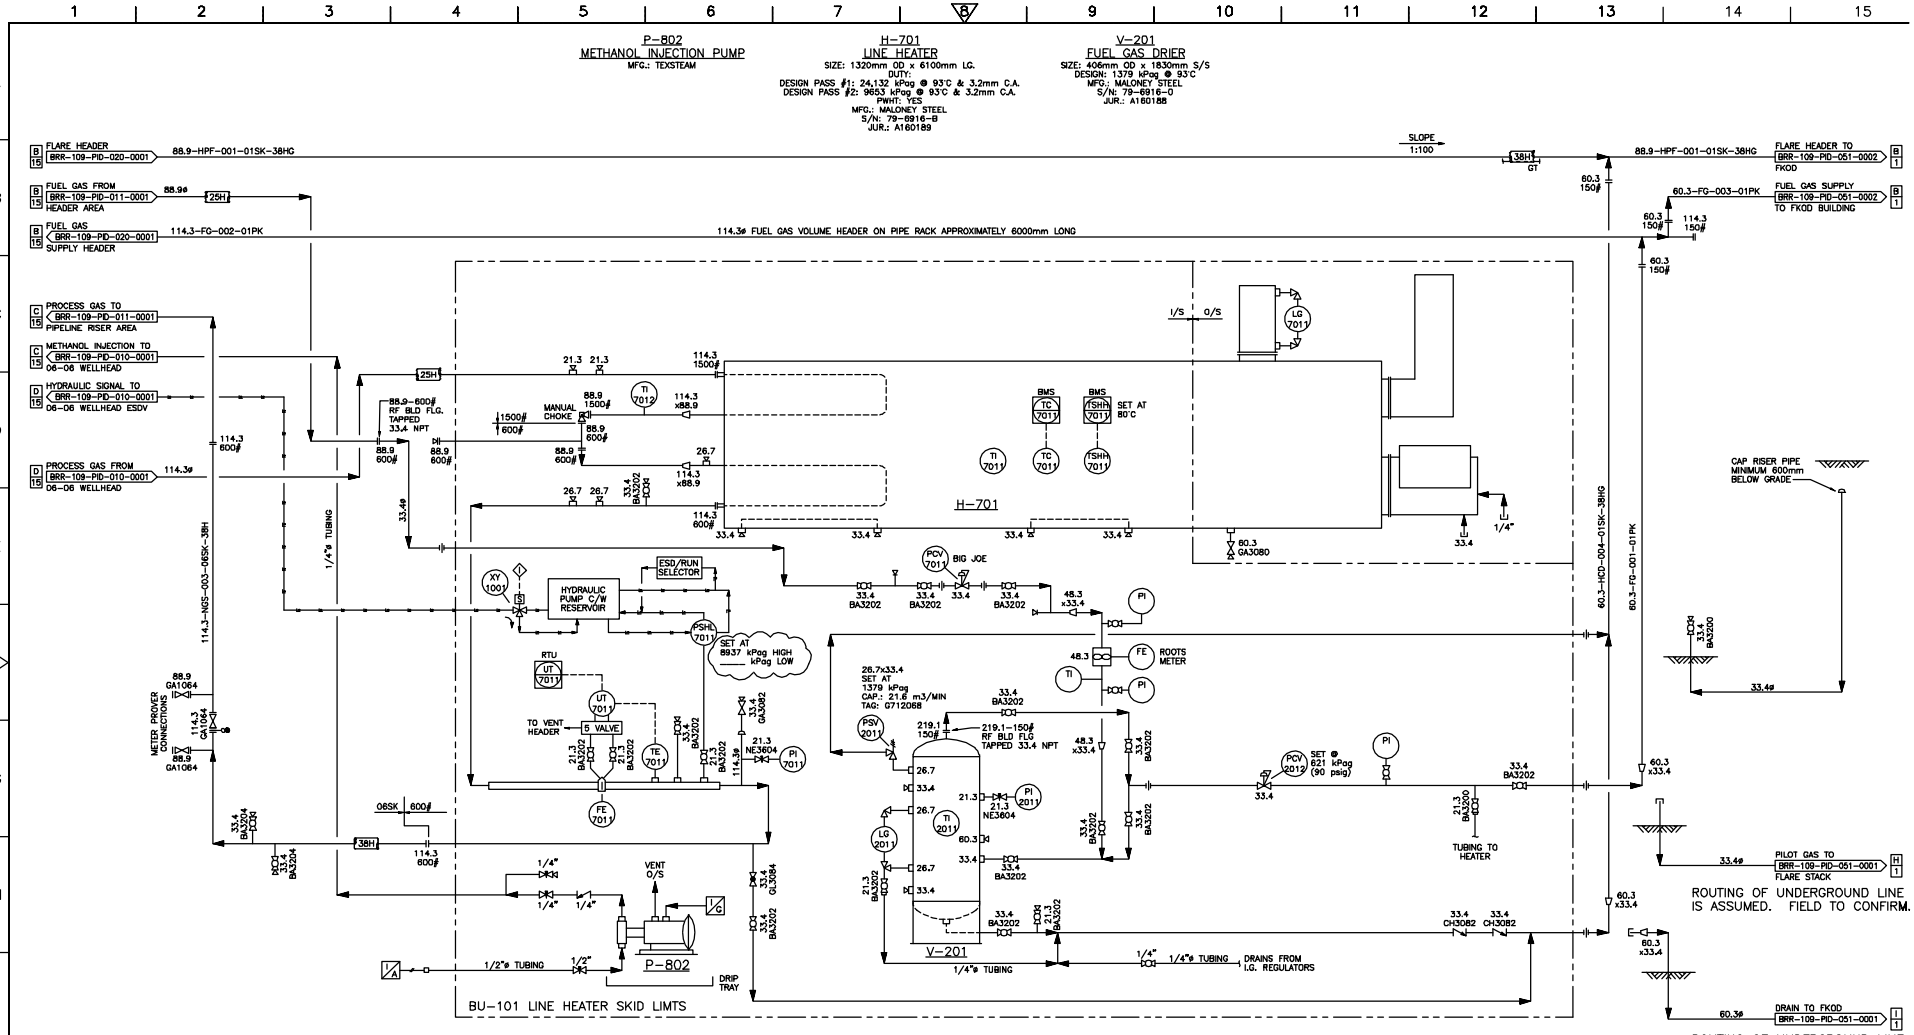

NOTES:

1. "BMS" INDICATES THE LINE HEATER BURNER MANAGEMENT SYSTEM.

REFERENCE DRAWINGS	
DWG No.	TITLE

PROJECT VERSION (Clear cell info prior to returning to CPC)							
VER.	DATE	BY	CHK'D DFTG	CHK'D ENG	APP'D PM	VERSION ISSUE

REVISIONS						
REV.	DATE	BY	CHK'D DFTG	CHK'D ENG	APP'D PM	REVISION ISSUE
0	10/07/08	GF				AS-BUILT AS PER JUNE 2010 SITE VISIT (NETWORK #10281434) (BY CPC)
1	10/11/22	CF				MOD'S FOR COMPR. ADD'N ISSUED FOR CONSTR. (NETWORK #10281434) (BY CPC)
2	11/06/17	JFC				AS-BUILT / MOC #29018 (NETWORK No. 10281434) (BY CPC)

ENGINEERING SEAL

PREPARED BY ConocoPhillips Canada

PERMIT

ConocoPhillips Canada

BRAZEAU RIVER 06-06 WELLSITE

LINE HEATER AREA

PIPING AND INSTRUMENTATION DIAGRAM

LEGAL DESC. FROM: 06-06-048-12 W5M

LEGAL DESC. TO (IF APPL.

LEGACY DWG NO.:

SCALE: NTS

DATE: 10/07/10

CPC DWG. NO.: BRR-109-PID-030-0001

REV.: 2

ENG. OR. PROJ. NO.: