C-1
GAS COMPRESSOR

FRICK: MODEL XJF-151L
OPERATING SPEED: 900 TO 1800 RPM
SUCTION PRESSURE: 5-100 PSIG
DISCHARGE PRESSURE: 10-300 PSIG
MAX. DISCHARGE PRESSURE: 348 PSIA
MAX. DISCHARGE TEMPERATURE: 250 DEG.F
FLOW: SEE CURVES
WEIGHT: 1195 LBS

V-2
PRIMARY OIL SEPARATOR

SIZE: 18" O.D. X 60" S/S
M.A.W.P.: 400 PSIG @ 250 DEG.F
M.D.M.T.: -20 DEG.F @ 400 PSIG
C.A.: 0.0625"
WEIGHT: 750 LBS.

CP-1
CONTROL PANEL

TYPE: MURPHYMATIC CONTROL PANEL
MODEL: TTDJr-IGN-T
IGNITION POWERED

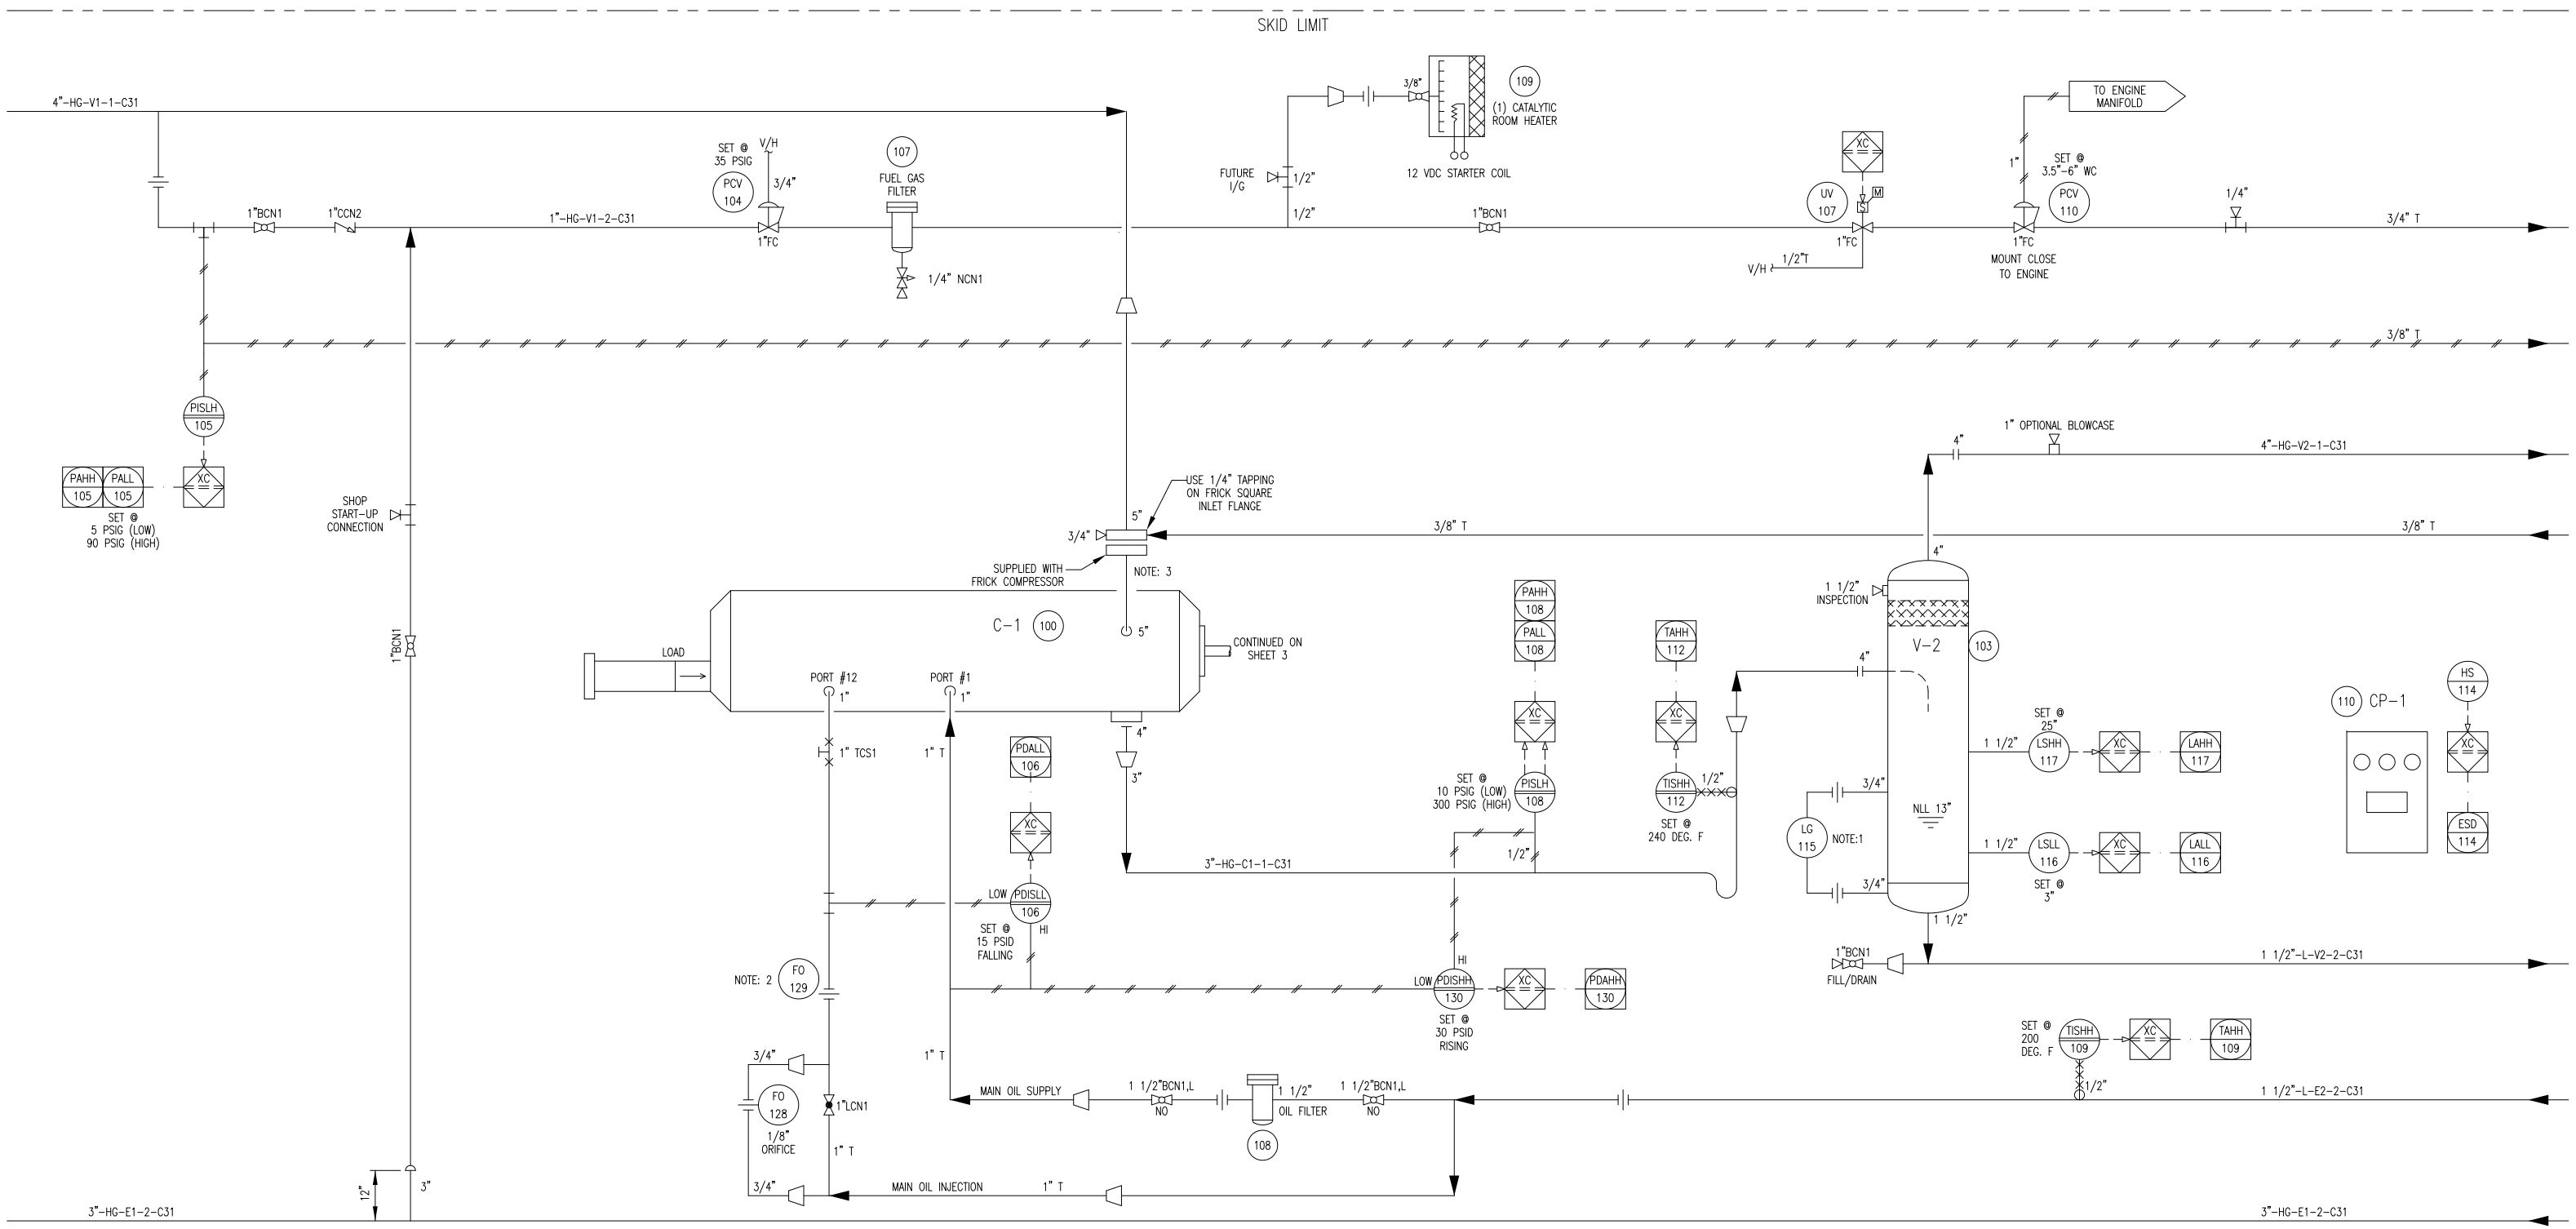

NOTE:1 CENTER OF GAUGE TO BE 13" FROM LOWER SEAM.
NOTE:2 ORIFICE SUPPLIED WITH COMPRESSOR
NOTE:3 INTEGRAL STRAINER SUPPLIED WITH COMPRESSOR

REV.	DESCRIPTION	DATE	BY	APPR.
2	AS BUILT	JAN 22/04	SS	
1	ISSUED FOR CONSTRUCTION	JUL 31/03	CD	GS

PERMIT TO PRACTICE STAMP

ENGINEER STAMP

TOROMONT PROCESS SYSTEMS

TITLE: P & I FLOW DIAGRAM

FOR: TOROMONT PROCESS SYSTEMS 135 HP COMPRESSOR UNIT FRICK 151N COMPRESSOR

DRAWN BY: C. DAVIDSON	DATE: JULY 23/03
CHKD. BY: G.SCHUSTER	SCALE: N/A
APPR. BY:	W.O. No: 11265101
CUST. PO No:	DWG. No: 11265-101
SHEET No: 2 OF 4	REV: 2