THE INFORMATION CONTAINED HEREIN IS THE CONFIDENTIAL PROPERTY OF TOROMONT PROCESS SYSTEMS AND IS NOT FOR PUBLICATION, AND NO PART THEREOF SHALL BE COPIED OR COMMUNICATED TO A THIRD PARTY WITHOUT AUTHORIZATION FROM TOROMONT PROCESS SYSTEMS.

F-2
FUEL GAS FILTER
TYPE: FINITE
MODEL: HN-45-10-CN
SIZE: 4" OD X 12" S/F
MAWP: 500 PSIG @ 175 DEG.F
SHELL MATERIAL: ALUMINUM
HEAD MATERIAL: ALUMINUM
ELEMENT: FINITE-10C
WEIGHT: 10 LBS

H-1A/B
CATALYTIC ROOM HEATER
TYPE: CATA-DYNE
HEAT OUTPUT: 22500 BTU/HR (EACH)
SIZE: 24" X 24"
STARTING ELEMENT: 12V W/ 25' CABLES
C/W PRESSURE REGULATOR
THERMOSTAT & SAFETY SHUTOFF
WEIGHT: 90 LBS.

T-3
USED OIL STORAGE TANK
SIZE: HSS 3/8"THK X 8" X 12" X 222" LG
LOCATION: SIDE OF SKID
VOLUME: 80 USGAL

CE-1
NATURAL GAS ENGINE
TYPE: CATERPILLAR 3306TA
BORE: 4.75"
STROKE: 6"
DISPLACEMENT: 638 CU.IN
COMPRESSION RATIO: 8.0: 1
SPEED RANGE: 1400-1800 RPM
BHP (RATED): 203 HP @ 1800 RPM
WEIGHT: 2090 LBS.

T-2
OIL DAY TANK
SIZE: HSS 1/4"THK X 12" X 12" X 120" LG
VOLUME: 68 USGAL

T-1A
TAW/CLOW GLYCOL SURGE TANK
SIZE: HSS 1/4"THK X 12" X 12" X 24" LG
VOLUME: 12 USGAL

T-1B
JW GLYCOL SURGE TANK
SIZE: HSS 1/4"THK X 12" X 12" X 15" LG
VOLUME: 6 USGAL

E-2
COMPRESSOR AFTERCOOLER/OIL COOLER/GLYCOL COOLER
TYPE: AIR-X-CHANGER
MODEL: 60BVI
AFTERCOOLER COIL: MAWP: 375 PSI @ 300 DEG.F
MDMT: -20 DEG.F @ 375 PSIG
DUTY: 240494 BTU/HR
GLYCOL COIL: MAWP: 14 PSI @ 300 DEG.F
(JACKET WATER) DUTY: 626802 BTU/HR
GLYCOL COIL: MAWP: 14 PSI @ 300 DEG.F
(TURBO/OIL COOLER GLYCOL) DUTY: 385014 BTU/HR
FAN: MOORE ED 27
FAN SPEED: 573 RPM
TOTAL AIR FLOW: 29752 SCFM
POWER DRAW: 9.8 HP
WEIGHT: 4250 LBS.

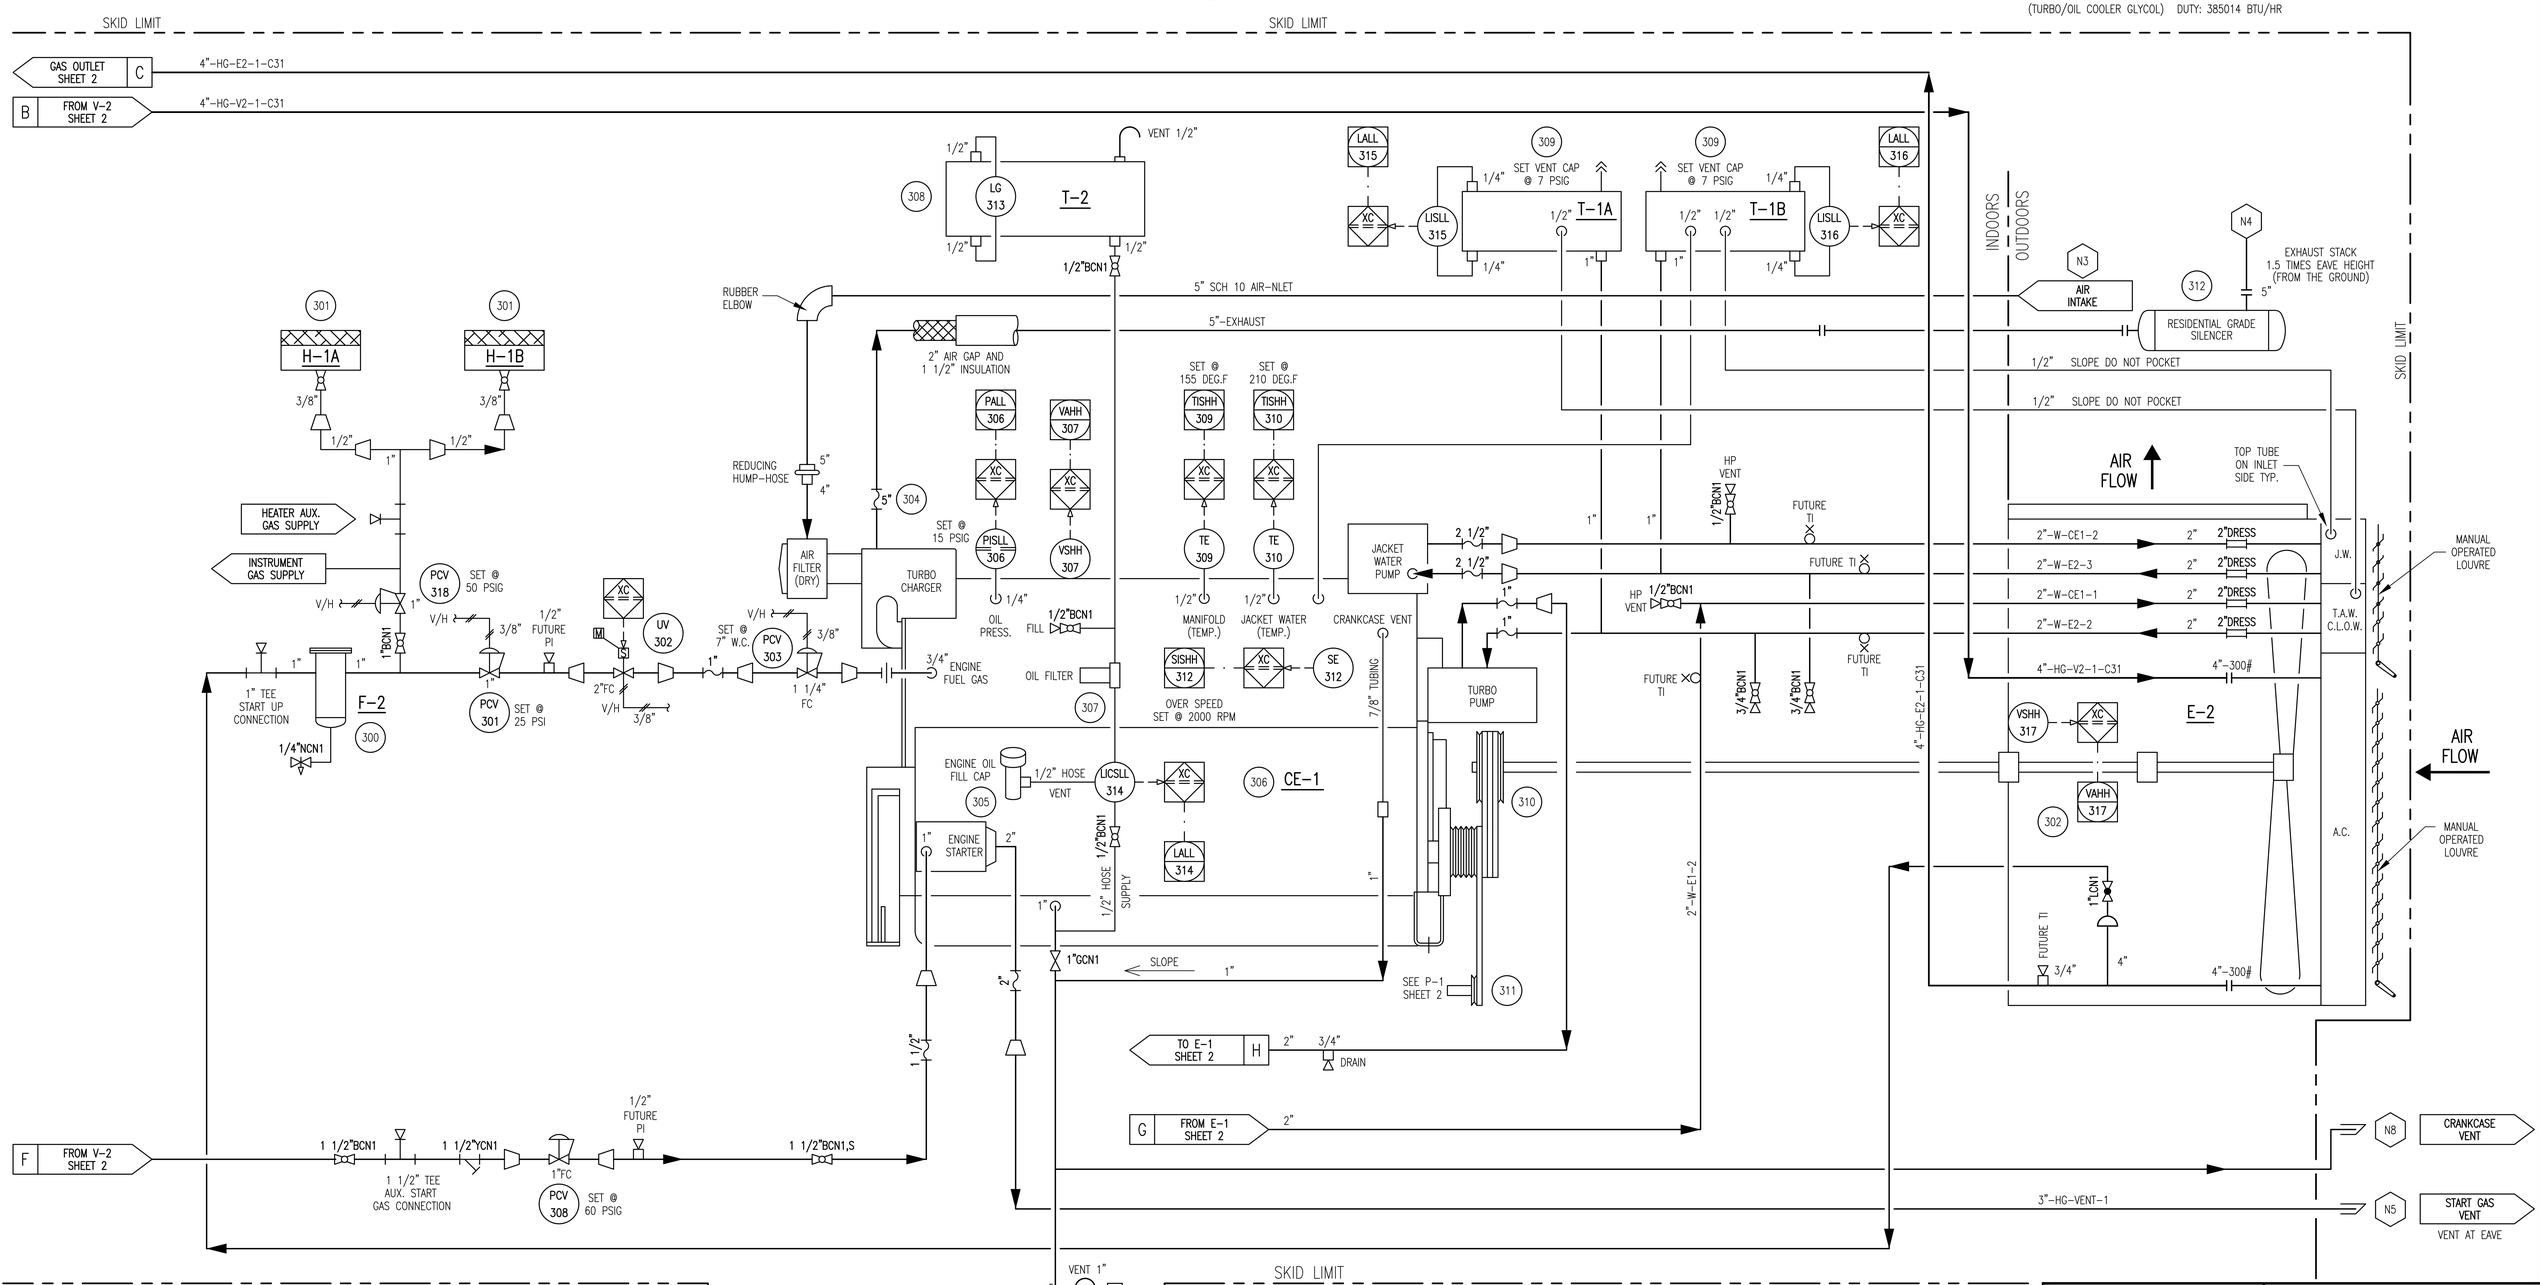

REV.	DESCRIPTION	DATE	BY	APPR.
2	AS BUILT	JUL 3/01	SS	
1	ISSUED FOR CONSTRUCTION	DEC 19/00	SB	GO

PERMIT TO PRACTICE STAMP

ENGINEER STAMP

TOROMONT / TOROMONT PROCESS SYSTEMS

TITLE: P & I FLOW DIAGRAM

FOR: CANADIAN HUNTER 200 HP BOOSTER COMPRESSOR

DRAWN BY: P. NOBLE	DATE: DEC. 19, 2000
CHKD. BY: G. O'GALLAGHER	SCALE: N/A
APPR. BY: G. O'GALLAGHER	W.O. No: 10682101
CUST. PO No:	

DWG. No: 10682-101 | SHEET No: 3 OF 4 | REV: 2