Document #	V2553-191126-1010	Rev 2

☑ 1. Approved (Work May Proceed)
☐ 2. Approved with Comments - Work May Proceed (Revise and Resubmit)
☐ 3. Not Approved (Stop Work per Attached Instructions)
☐ 4. Information Only

AUTHORIZATION TO PROCEED DOES NOT WAIVE SUPPLIER'S RESPONSIBILITY OR LIABILTY UNDER THE CONTRACT / PURCHASE ORDER FOR COMPLIANCE WITH THE REQUIREMENTS OF THE DRAWINGS AND SPECIFICATIONS

Signature — YY/MM/DD 12/16/19

PROPAK SYSTEMS LTD – AIRDRIE, AB

ZONE	REV	DESCRIPTION	DATE	DWN	CHK
	A	SEE SHEET 1 FOR REVISIONS	—		

PO #	Job #	W191126
P482340	Doc #	V2553-191126-1010
Equip #	VDR:	C7, C27
	Rev:	2

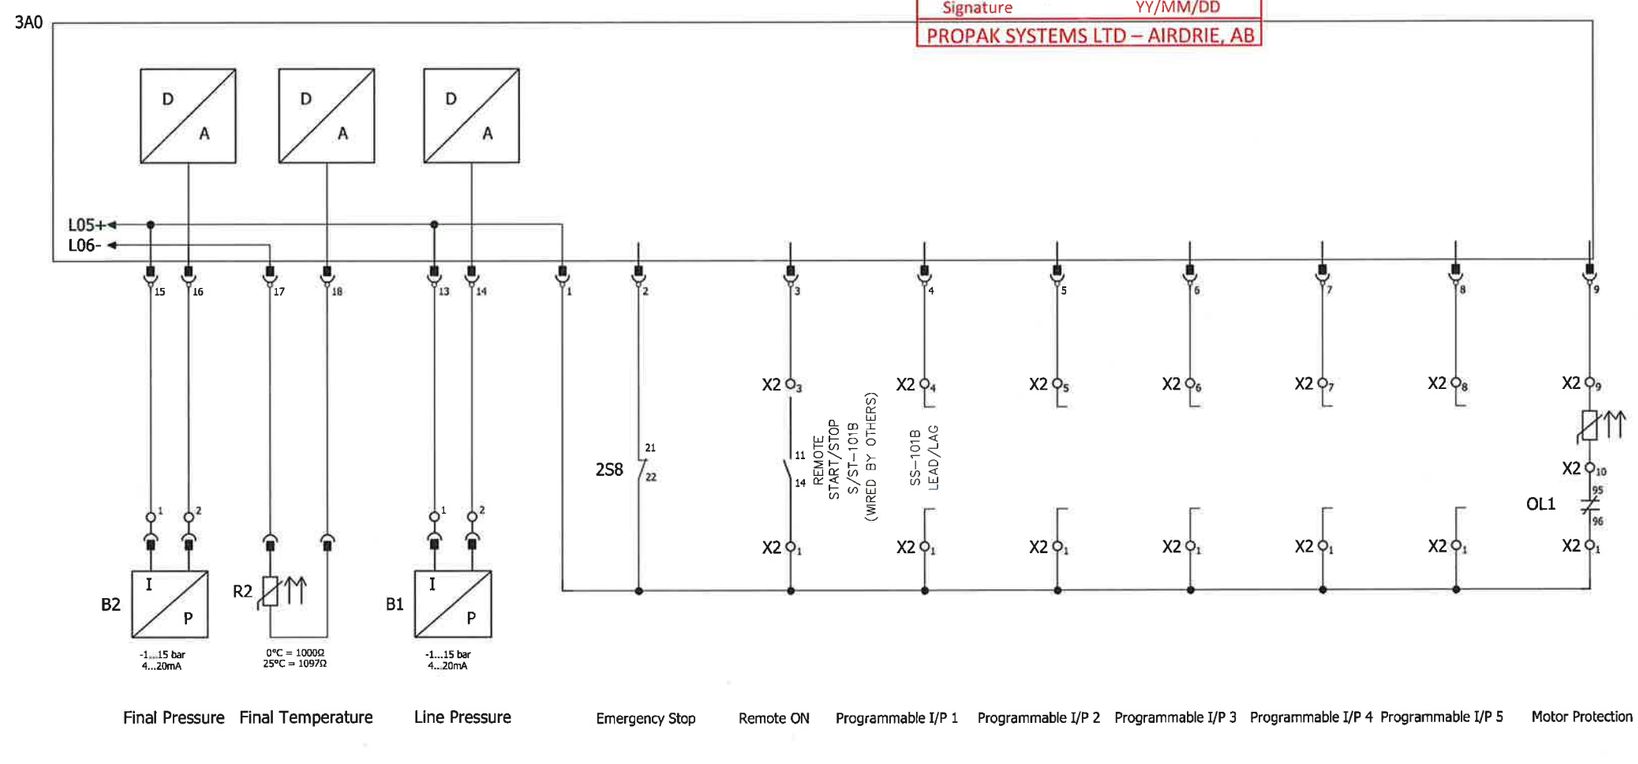

FINISH OF CHAMFERS & FILLETS TO CONFORM TO ROUGHNESS ADJACENT AREA. SURFACE ROUGHNESS MAX. PER ASME B46.1 SPEC. FULL THD DEPTHS ARE MINIMUM.

UNLESS OTHERWISE SPECIFIED DIMENSIONS ARE IN INCHES
TOL. ON DECIMALS: .X = ±.05
TOL. ON DECIMALS: .XX = ±.02
TOL. ON DECIMALS: .XXX AS SPECIFIED
TOL. ON ANGLES: ± 0°-30'

THIRD ANGLE PROJECTION

CONFIDENTIAL – THE INFORMATION CONTAINED IN THIS DOCUMENT IS THE PROPERTY OF GARDNER DENVER, INC. IT IS NOT FOR PUBLIC DISCLOSURE. POSSESSION OF THE INFORMATION DOES NOT CONVEY ANY RIGHT TO USE, SELL OR DISCLOSE THE INFORMATION. UNAUTHORIZED REPRODUCTION OR USE OF THE INFORMATION IS PROHIBITED. THIS DOCUMENT IS TO BE RETURNED TO GARDNER DENVER, INC. UPON THE COMPLETION OF THE PURPOSE FOR WHICH IT IS LOANED OR UPON REQUEST.

DIMENSIONING AND TOLERANCING PER ASME Y14.5M-1994 THREADS PER ASME B1.1 UNIFIED SYSTEM IN U.S.A., AND B1.20.1 & B1.20.3

Gardner Denver
Gardner Denver Inc. Quincy, IL

HEAT TREATMENT | ENG. REF:

TITLE: WIRING SCHEMATIC L07-11 575V 60Hz GD PILOT

DWN BY SS 03-24-15
CK'D BY TM 11-2-15
SIZE E | DRAWING NO. TS | 305EC8546 | REV A
SCALE NTS | SHEET 3 of 3

El. Control L07-11 V2
460V-60Hz-DELCOS Pro

REV	DESCRIPTION	DATE	DWN	CHK
2	REVISED & RE-ISSUED FOR CONSTRUCTION	2019-12-09	HH	HAY
1	REVISED & RE-ISSUED FOR CONSTRUCTION	2019-11-25	HH	HAY
0	ISSUED FOR APPROVAL	2019-10-28	HH	HAY

NORTHWEST EQUIPMENT LTD.
A SWIFT INDUSTRY COMPANY

COMPAIR/GD ELECTRICAL WIRING DIAGRAM

DUPLEX COMPAIR/GD L07-130 INSTRUMENT AIR COMPRESSOR PACKAGE (FC1-WS1-PK-1300)

CLIENT	CENOVUS c/o PROPAK	SCALE	NTS
LOCATION	FOSTER CREEK WEST PADS SAP, AB	DWN BY	HH
LSD	TBA PO# P482340	DATE	2019-10-28

JOB	DWG	REV
NW2165-RH	NW2165EL2B (Sheet 3 of 3)	2