V-321
HORIZONTAL INLET GAS COALESCER

VENDOR: GEQUIP
SIZE: 168mm O.D. x 3658mm F/F
C/W 168.3mm OD x 905mm LG BOOT
D.P.: 9756 kPag @ -29/66°C
C.A.: 1.6mm

C-322
GLYCOL CONTACTOR

VENDOR: SPECTRUM
SIZE: 762 I.D. x 10363mm S/S
D.P.: 9756kPag @ -29/66°C
C.A.: 1.6mm
(12) TRAYS @ 610mm SPACING

E-323
GAS/GLYCOL EXCHANGER

VENDOR: SPECTRUM
SIZE: 219mm O.D.x114mm O.D.x3048mm LONG
T.S.: 9722 kPag @ -29/66°C
S.S.: 9722 kPag @ -29/121°C
C.A.: 1.6mm
FINNED PIPE IN PIPE DESIGN

V-324
GLYCOL LEVEL CAGE

VENDOR: SPECTRUM
SIZE: 168mm O.D. x 762mm S/S
D.P.: 9791kPag @ -29/65.6°C

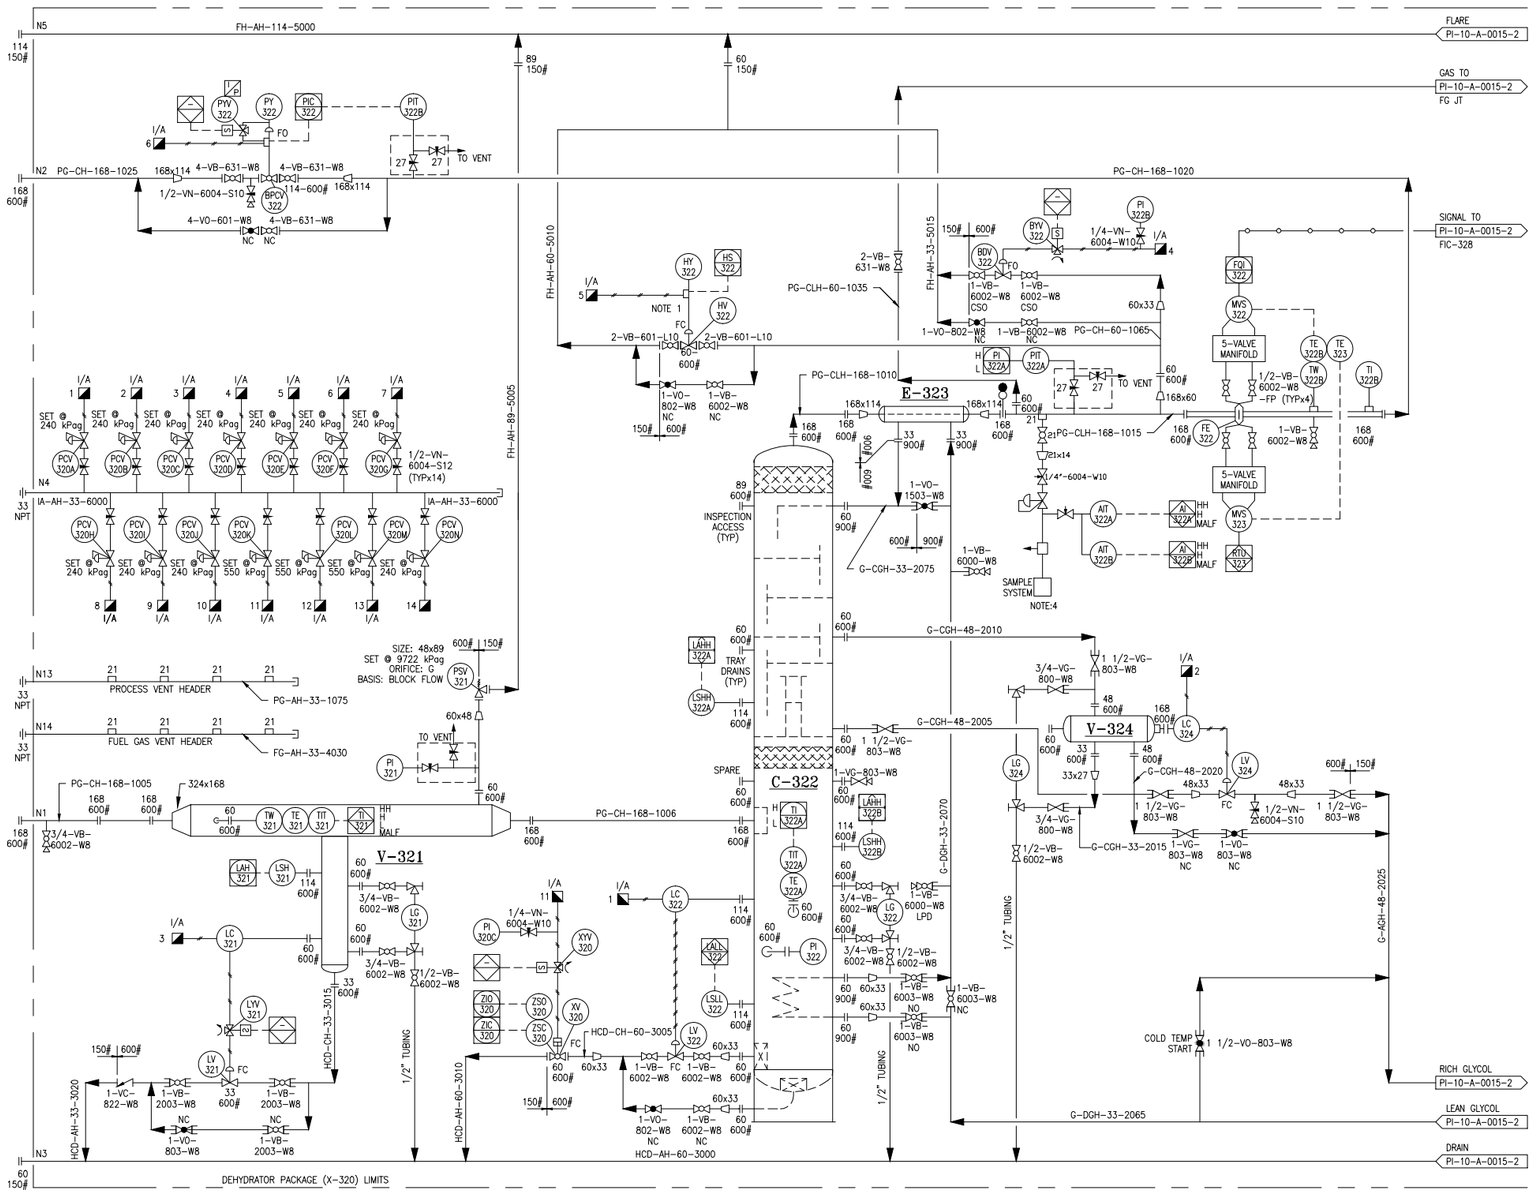

EXCELSIOR JOB# 4178 HUS-POP-0003

NOTES:

1. HV-322 SIZED FOR 7.5 MMSCFD FOR FLARING OF FULL CAPACITY OF ONE COMPRESSOR WHEN WATER CONTROL EXCEEDS SALES SPEC.
2. INSTALLATION BY HUSKY.
3. MOUNT HEATED REGULATOR AS CLOSE AS POSSIBLE SAMPLE PROBE.
4. FREE-ISSUED DEWPOINT ANALYZER.

No.	DATE	REVISIONS	BY	CHK	REW	APP	PM	No.	DATE	REVISIONS	BY	CHK	REW	APP	PM
A	JUL 08, 2014	ISSUED FOR APPROVAL	LG					3	JAN 16, 2015	AS-BUILT	JC				
B	AUG 27, 2014	RE-ISSUED FOR APPROVAL	LG												
0	SEP 10, 2014	ISSUED FOR CONSTRUCTION	AK												
1	NOV 07, 2014	REMOVED HOLD; ADDED HOLD ON BDV-322	LG	TMD	JH	JH	LA								
2	NOV 28, 2014	REMOVED HOLD; REVISED PRESSURES; ADDED FLANGE, LINE NO.	LG												

THIS DRAWING IS THE PROPERTY OF SPECTRUM PROCESS SYSTEM INC. AND LOANED TO THE RECIPIENT FOR HIS CONFIDENTIAL USE ONLY. IN CONSIDERATION OF THE LOAN OF THIS DRAWING, THE RECIPIENT PROMISES AND AGREES THAT IT SHALL NOT BE USED IN ANY WAY DETRIMENTAL TO THE INTEREST OF SPECTRUM PROCESS SYSTEM INC., THAT IT SHALL BE RETURNED UPON REQUEST, AND THAT IT SHALL NOT BE REPRODUCED, COPIED, LENT OR OTHERWISE DISPOSED OF DIRECTLY OR INDIRECTLY, NOR USED FOR ANY PURPOSE OTHER THAN THAT INTENDED WITHOUT THE WRITTEN PERMISSION OF SPECTRUM PROCESS SYSTEM INC.

ENGINEERS RECORD		DATE
DRAWN BY	LERIC GALARSE	JUL 03, 2014
CHECKED BY	TANYA DIXON	NOV 07, 2014
REVIEWED BY	JASON HYSHKA	NOV 07, 2014
APPROVED BY	JASON HYSHKA	NOV 07, 2014
PM APPD. BY	LANE ARIAS	NOV 06, 2014
Q.C. APPD. BY		

SPECTRUM Process Systems

P.O. # 8400843246

CLIENT: HUSKY ENERGY c/o EXCELSIOR ENGINEERING

PROJECT: DEHYDRATION AND JT PACKAGE LSD: 02-20-050-18 W5M COMPRESSOR STATION RAVEN CREEK

TITLE: PIPING AND INSTRUMENTATION DIAGRAM

Scale	JOB No.	DWG. No.	REV.
NTS	SPS-14-05110	F-14-05110-01-001	3