


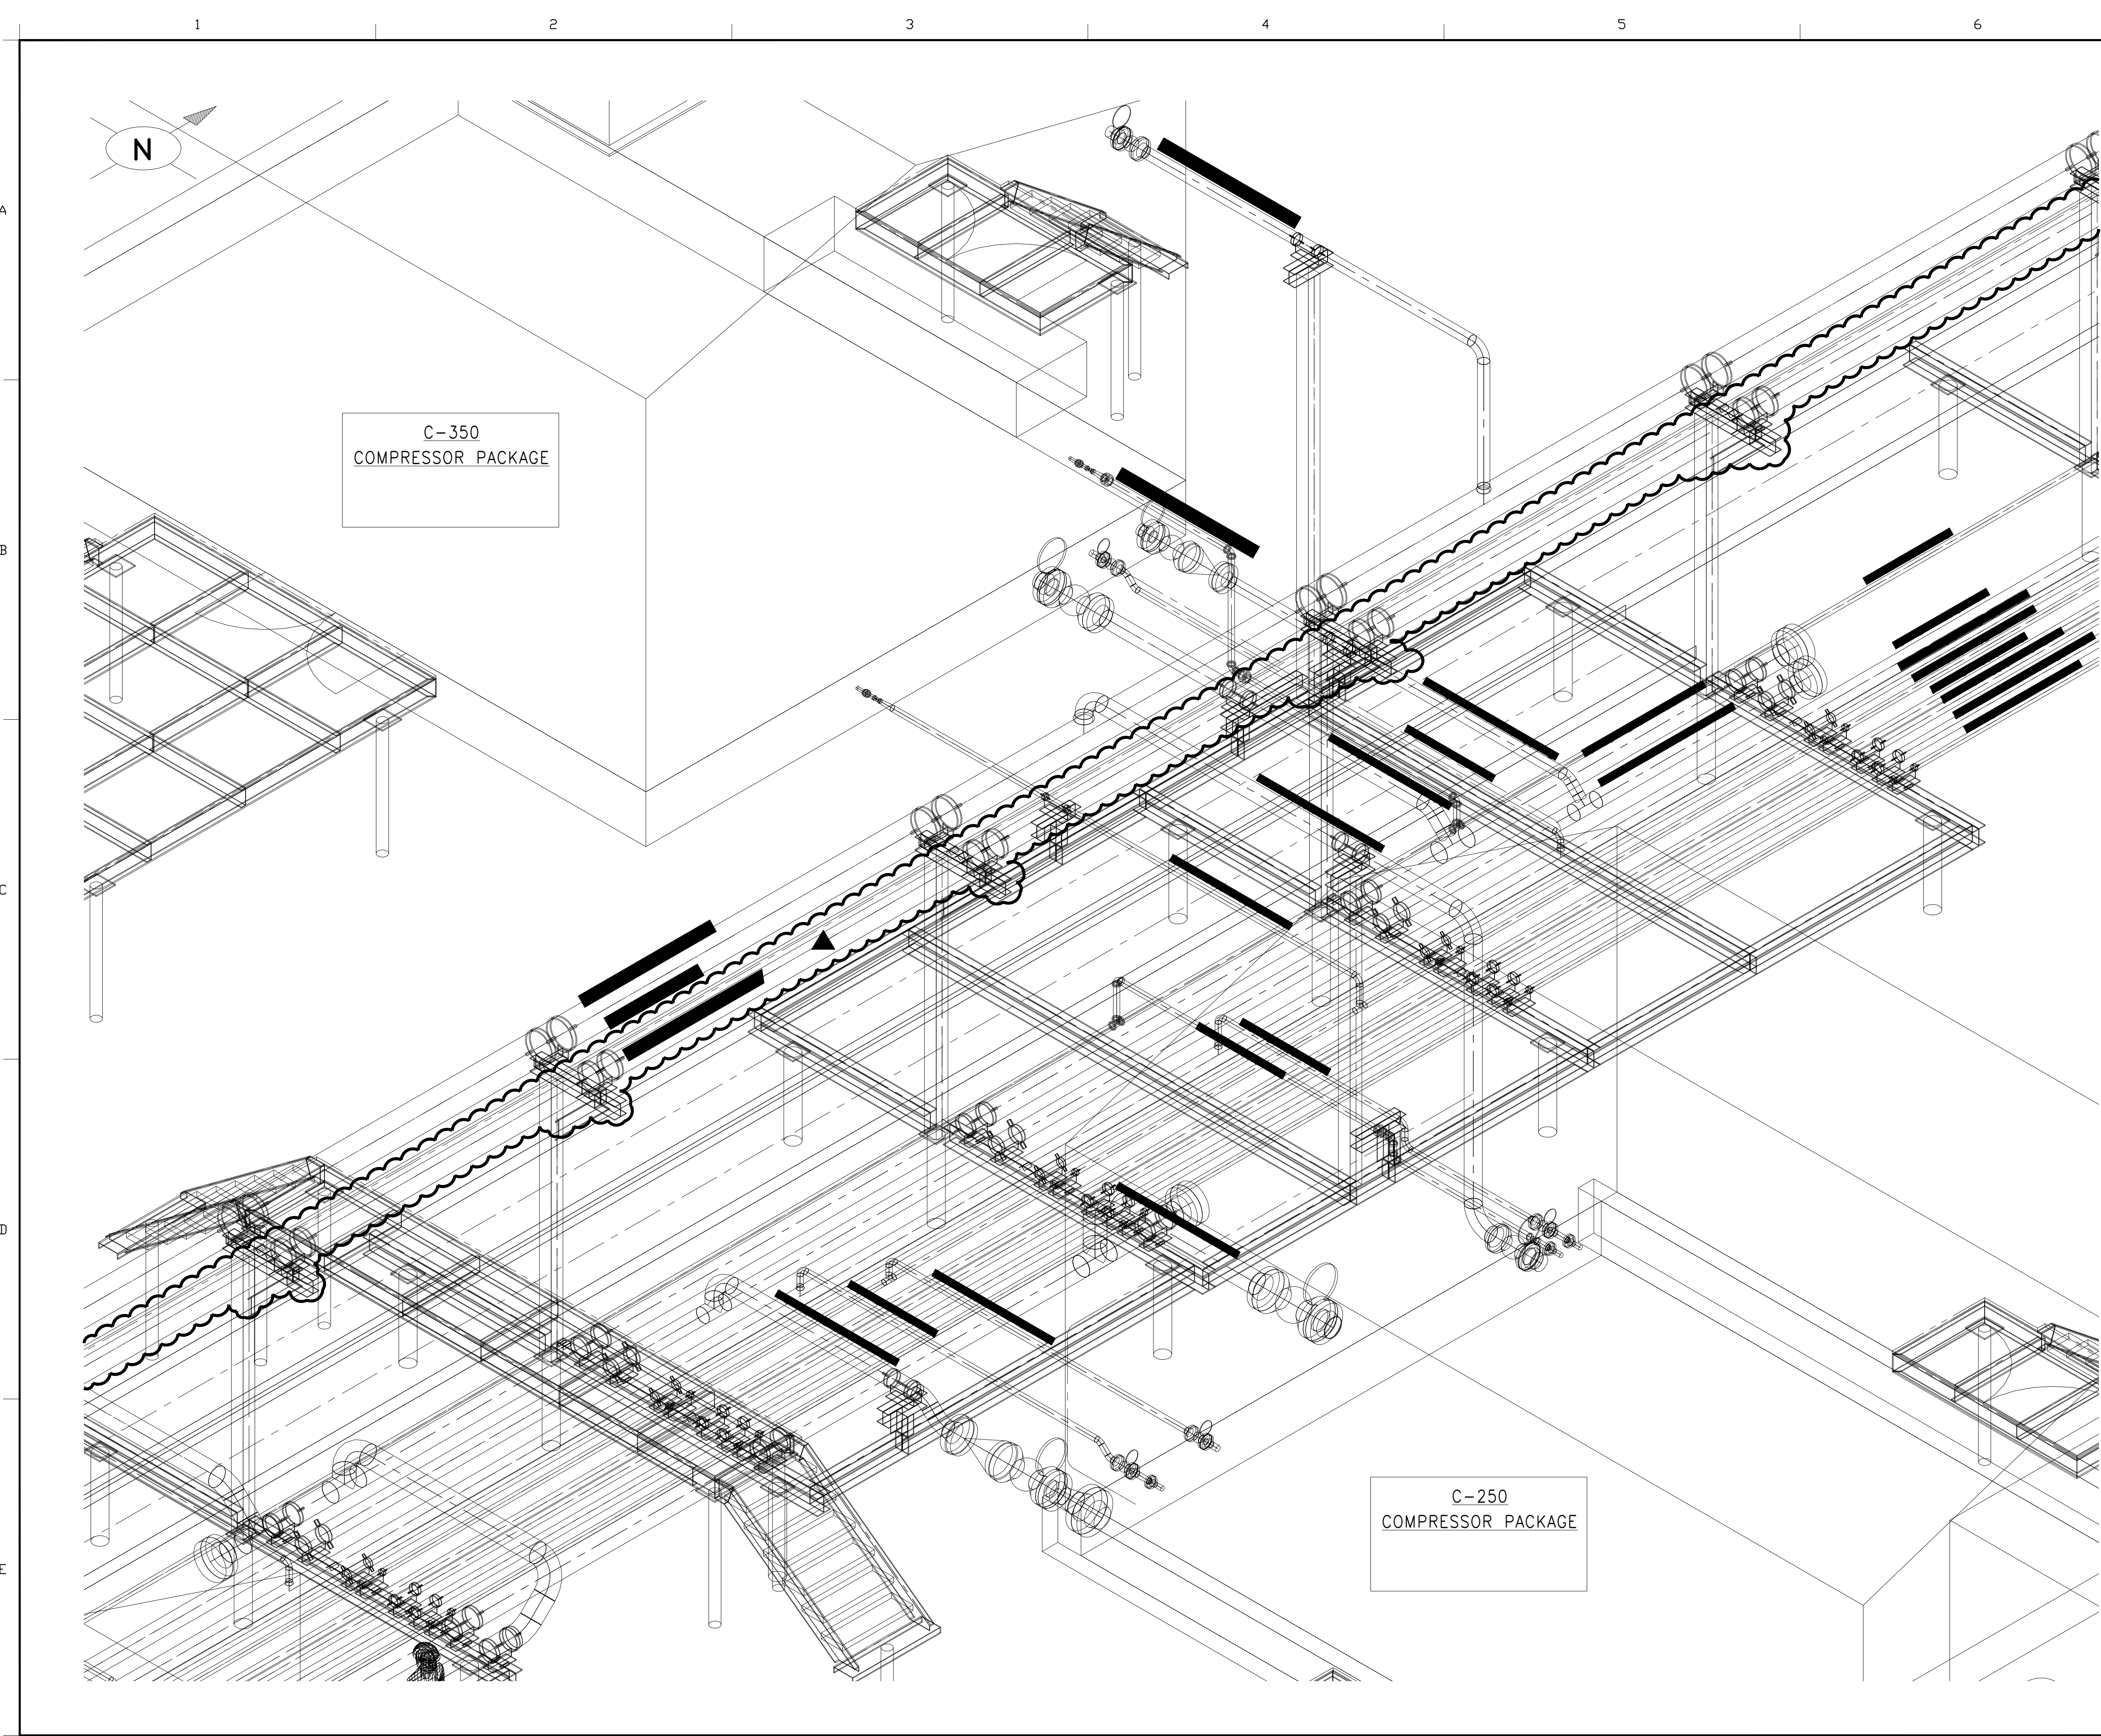

NOTES

ENGINEERING COMPANY PERMIT STAMP

REGISTERED PROFESSIONAL ENGINEER STAMP

REF	DRAWING NUMBER	DRAWING TITLE					
REFERENCE DRAWINGS							
3	2012/10/04	IFC FOR EWR 15740 EXCELSIOR 3245	AR				
2	2011/12/08	AS BUILT FOR EWR 11959 EXCELSIOR 2479	CD				
1	2011/04/30	IFC FOR EWR 11959 EXCELSIOR 2479	RN				
REV	DATE	DESCRIPTION	BY	CHK	ENG	APR	
REVISION HISTORY							
Husky Oil Operations Limited 							
MINEHEAD 03-06-049-18W5 COMPRESSOR STN.							
TITLE		C-250 & C-350 COMPRESSOR AREA ISOMETRIC VIEW PIPING & MECHANICAL					
SURFACE LOCATION		03-06-049-18W5					
ALTERNATE DWG NUMBER			REV NO				
HUSKY DWG NUMBER			03-06-049-18W5-PM-0044-01			3	
VENDOR DWG NUMBER						SCALE	
AMU/FLOC NUMBER						1:30	
DCN NO		PROJECT NO		EWR 15740			

