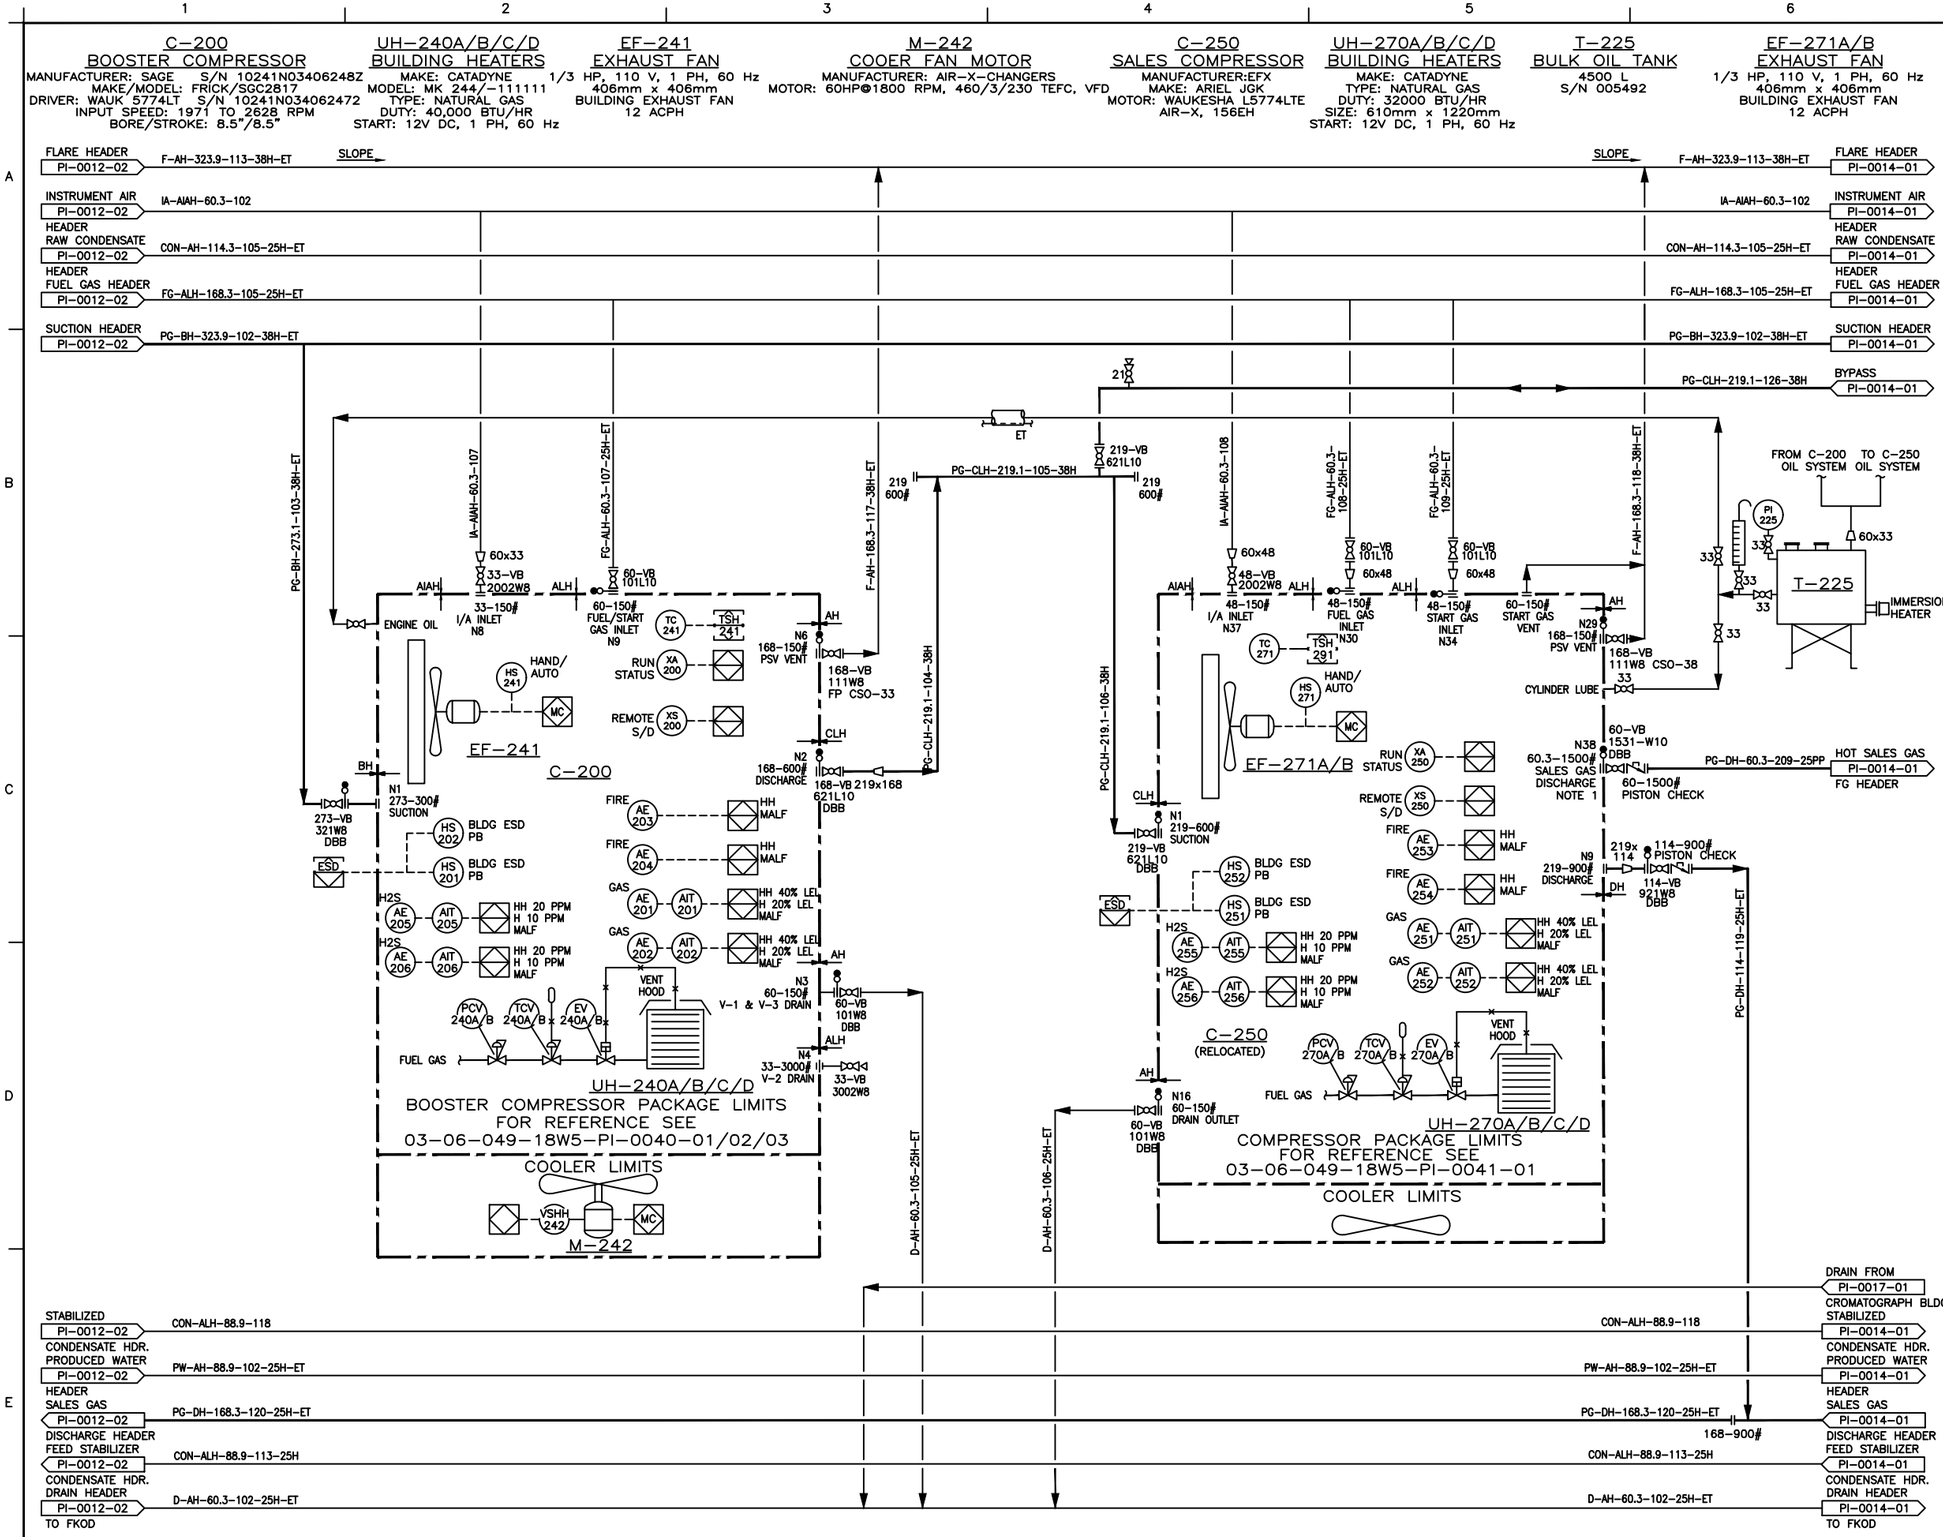

NOTES

1. FOR TIE-IN LOCATION SEE VENDOR DWG REDLINE 17006-05.

ENGINEERING COMPANY PERMIT STAMP

REGISTERED PROFESSIONAL ENGINEER STAMP

REF	DRAWING NUMBER	DRAWING TITLE
6		
5		
4		
3		
2		
1		

REFERENCE DRAWINGS

REV	DATE	DESCRIPTION	BY	CHK	ENG	APR
6	2013/12/01	AS BUILT FOR EWR 18650 EXCELSIOR 3897	JD			
5	2013/10/03	IFC FOR EWR 18575 EXCELSIOR 3942	TMD			
10	2018/03/07	AS BUILT FOR MOC EI10894387	SK	CM	CM	CM
9	2016/05/24	UPDATED FOR MOC 16505791	KZ	BRM	CM	
8	2015/09/02	IFC FOR EWR 20153 STANTEC 110901789	BIK			
7	2014/05/22	AS BUILT FOR EWR 18575 EXCELSIOR 3942HUS	AR			

REVISION HISTORY

Husky Oil Operations Limited

MINEHEAD 03-06-049-18W5 COMP STN – NORTH

TITLE BOOSTER (C-200) & SALES COMPRESSORS (C-250)-TRAIN 1
PIPING & INSTRUMENTATION DIAGRAM

SURFACE LOCATION	03-06-049-18W5	
ALTERNATE DWG NUMBER		REV NO
HUSKY DWG NUMBER	03-06-049-18W5-PI-0013-01	10
VENDOR DWG NUMBER		SCALE
AMU/FLOC NUMBER	FH-AN-001-00005	NTS
DCN NO	PROJECT NO MOC EI10894387	