JUNCTION BOX: JB-C/A 250

24VDC CONTROL AND ANALOG

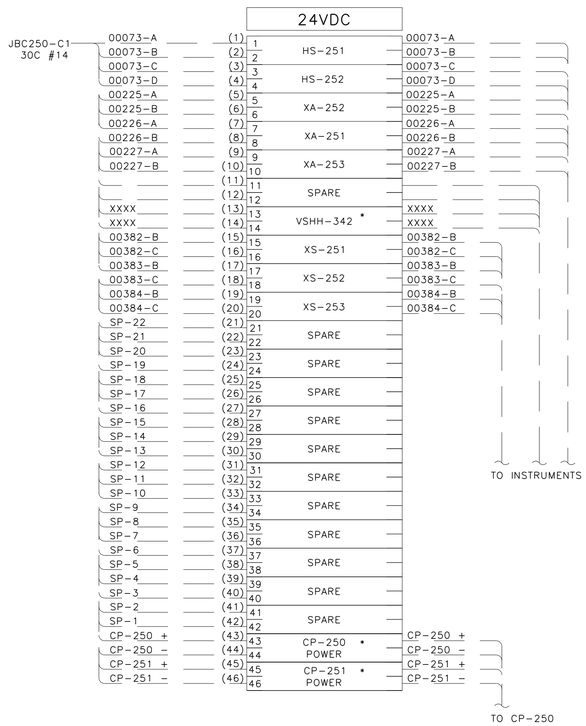

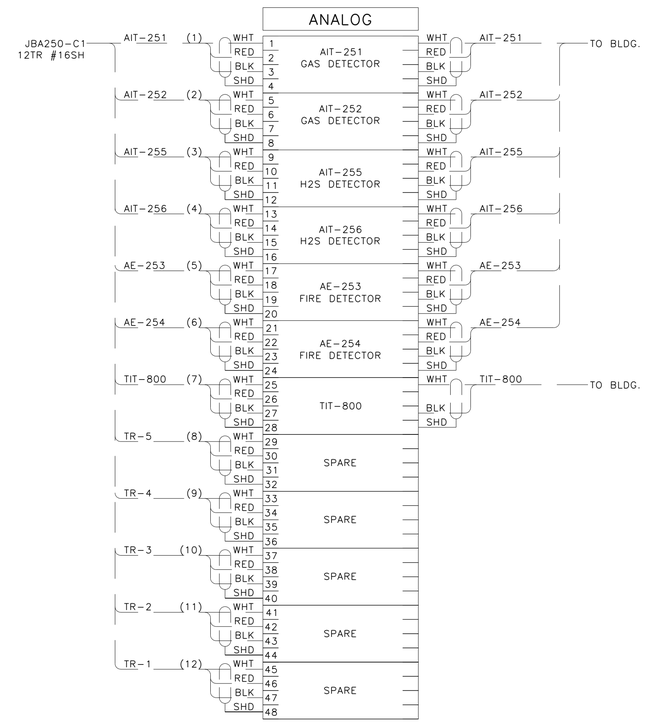

NOTES

* = VSHH-342 AND CP-250,251 = UNKNOWN

ENGINEERING COMPANY PERMIT STAMP

REGISTERED PROFESSIONAL ENGINEER STAMP

REF	DRAWING NUMBER	DRAWING TITLE

REFERENCE DRAWINGS

REV	DATE	DESCRIPTION	BY	CHK	ENG	APR
4	2013/12/02	AS BUILT FOR EWR 18650 EXCELSIOR 3897	MB	SSTJ	FJ	VD
3	2013/07/29	REVISION CANCELLED FOR EWR 17708 EXCELSIOR 3609				
2	2011/10/21	AS-BUILT	DP	MPB		
1B	2011/07/06	ISSUED FOR CONSTRUCTION – FIELD	DP	MPB		
1A	2011/05/20	ISSUED FOR BID – FIELD	DP	MPB		

REVISION HISTORY

Husky Oil Operations Limited

EXCELSIOR ENGINEERING LTD

MINEHEAD 03-06-049-18W5 COMPRESSOR STN.

TITLE: C-250 SALES COMPRESSOR JUNCTION BOX LAYOUTS SHEET 2

SURFACE LOCATION	03-06-049-18W5	
ALTERNATE DWG NUMBER		REV NO
HUSKY DWG NUMBER	03-06-049-18W5-EL-0107-02	4
VENDOR DWG NUMBER		SCALE
AMU/FLOC NUMBER	FH-AN-001-00005	
DCN NO	PROJECT NO EWR 18650	