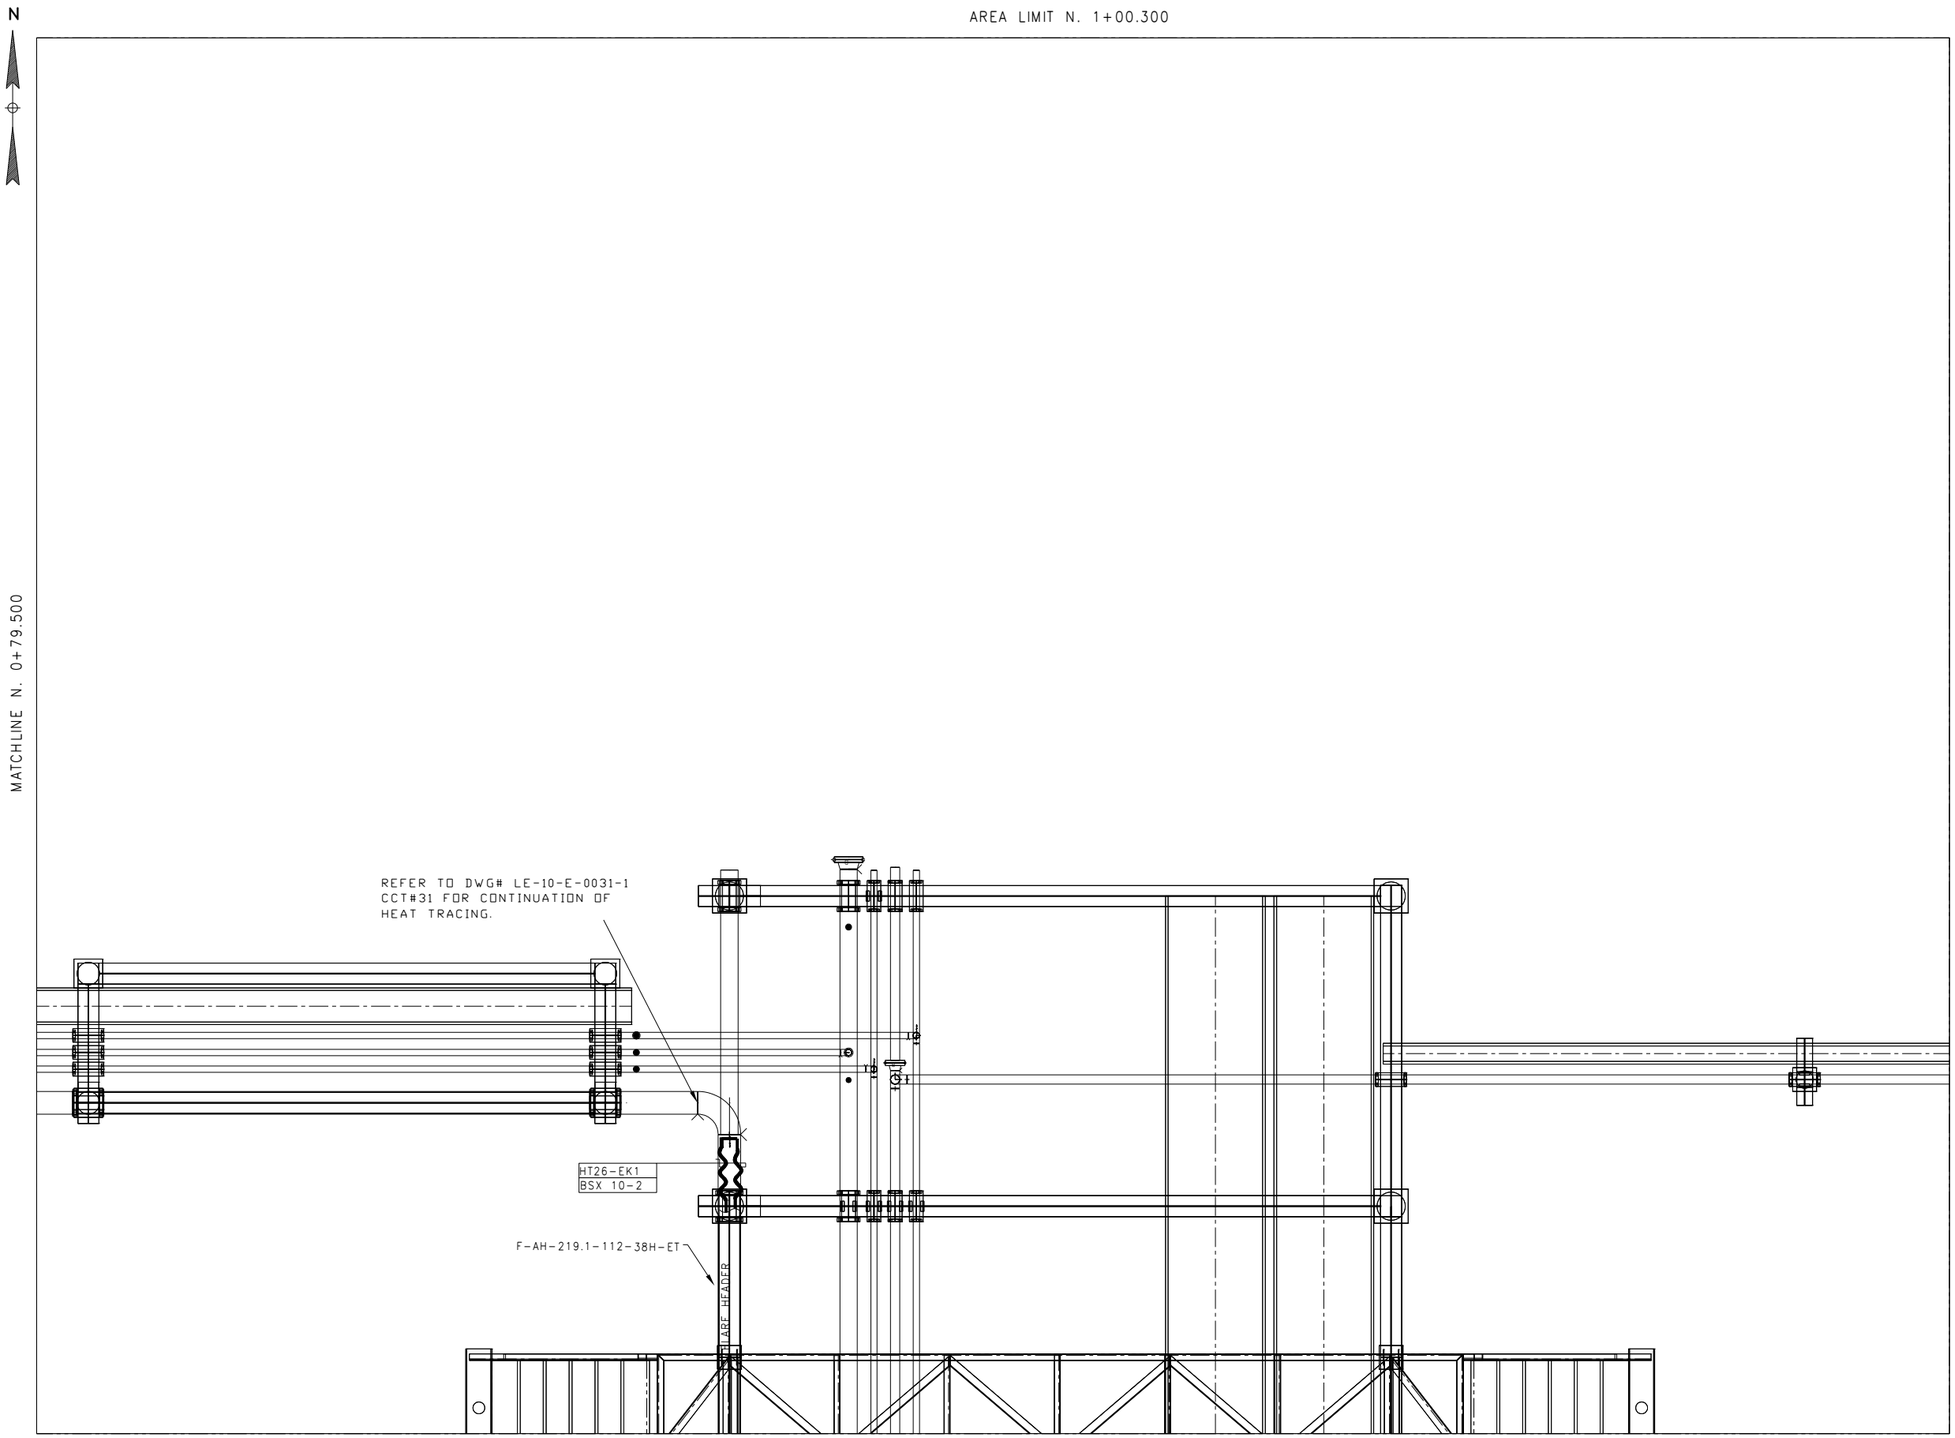

ENGINEERING COMPANY PERMIT STAMP

REGISTERED PROFESSIONAL ENGINEER STAMP

WHEN SIGNED & DATED, THE ENGINEERING SEAL & PERMIT AFFIXED ABOVE WILL APPLY TO THE CLOUDED AREAS FOR THE CURRENT REVISION ONLY.

	DRAWING NUMBER	DRAWING TITLE
6		
5		
4		
3		
2		
1		

REFERENCE DRAWINGS

	DATE	DESCRIPTION	BY	CHK	ENG	APR
2	2014/09/03	AS BUILT FOR EWR 18319 EXCELSIOR 3829	AE	SSTJ	FJ	VD
1	2014/03/17	IFC FOR EWR 18319 EXCELSIOR 3829	AM	SSTJ	FJ	VD

REVISION HISTORY

Husky Oil Operations Limited

EXCELSIOR ENGINEERING LTD

RAVEN CREEK 02-20-050-18W5 COMPRESSOR STN

TITLE

02-20 MCC AREA
HEAT TRACING PLOT PLAN LAYOUT/HT CIRCUIT #26
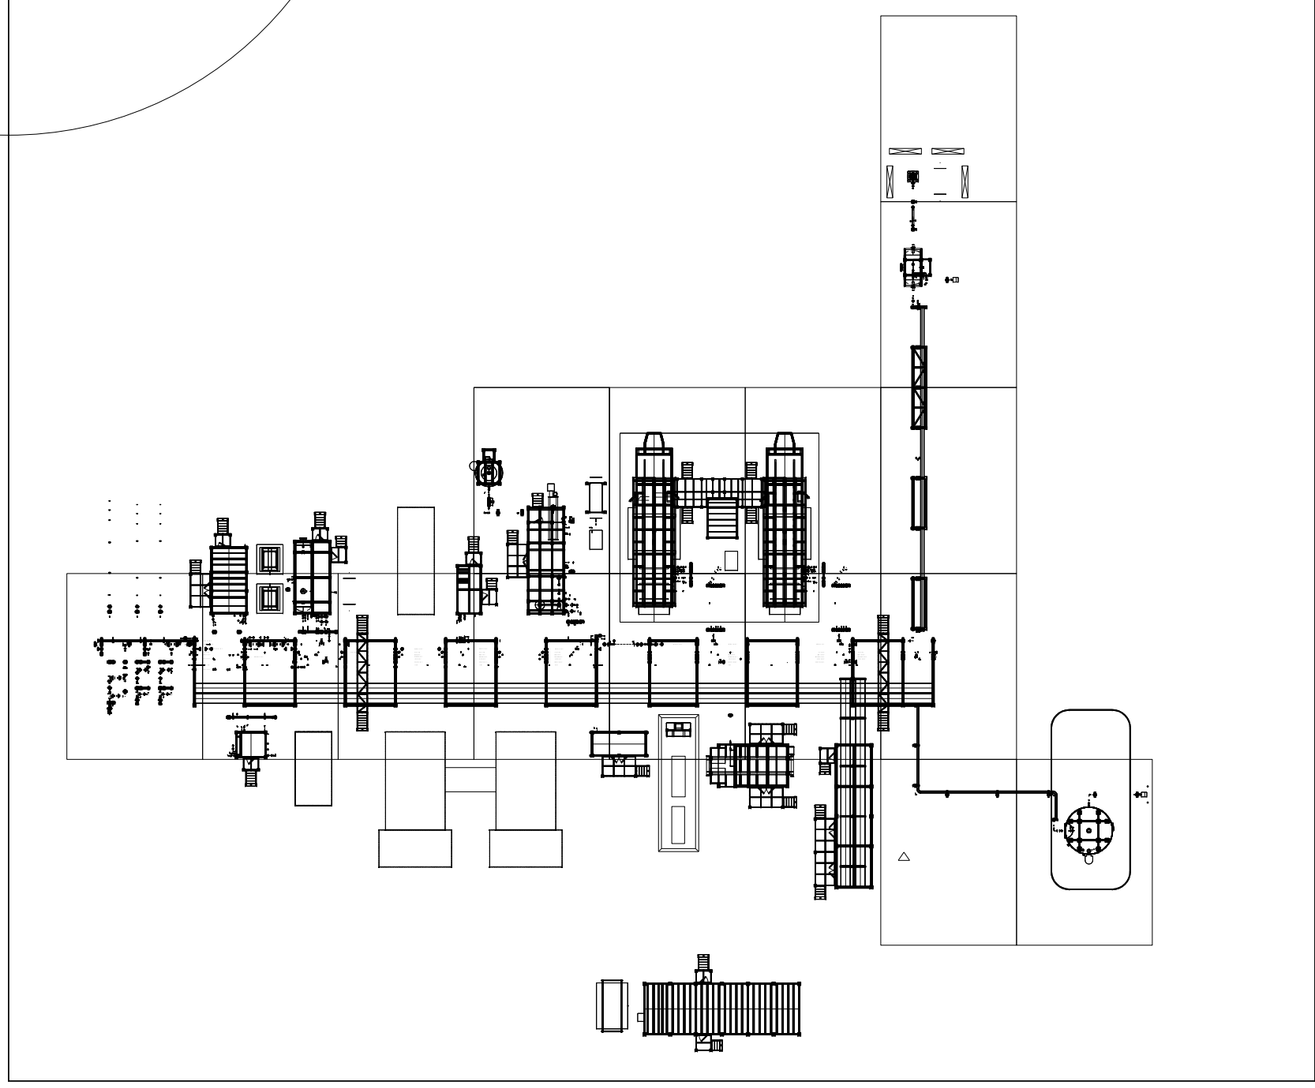
SURFACE LOCATION	02-20-050-18W5	
ALTERNATE DWG NUMBER	LE-10-E-0026-3	REV NO
HUSKY DWG NUMBER	02-20-050-18W5-ET-0025-03	2
VENDOR DWG NUMBER		SCALE
AMU/FLOC NUMBER	FH-AN-001-00007	1:30
DCN NO	PROJECT NO 3829 EWR 18319