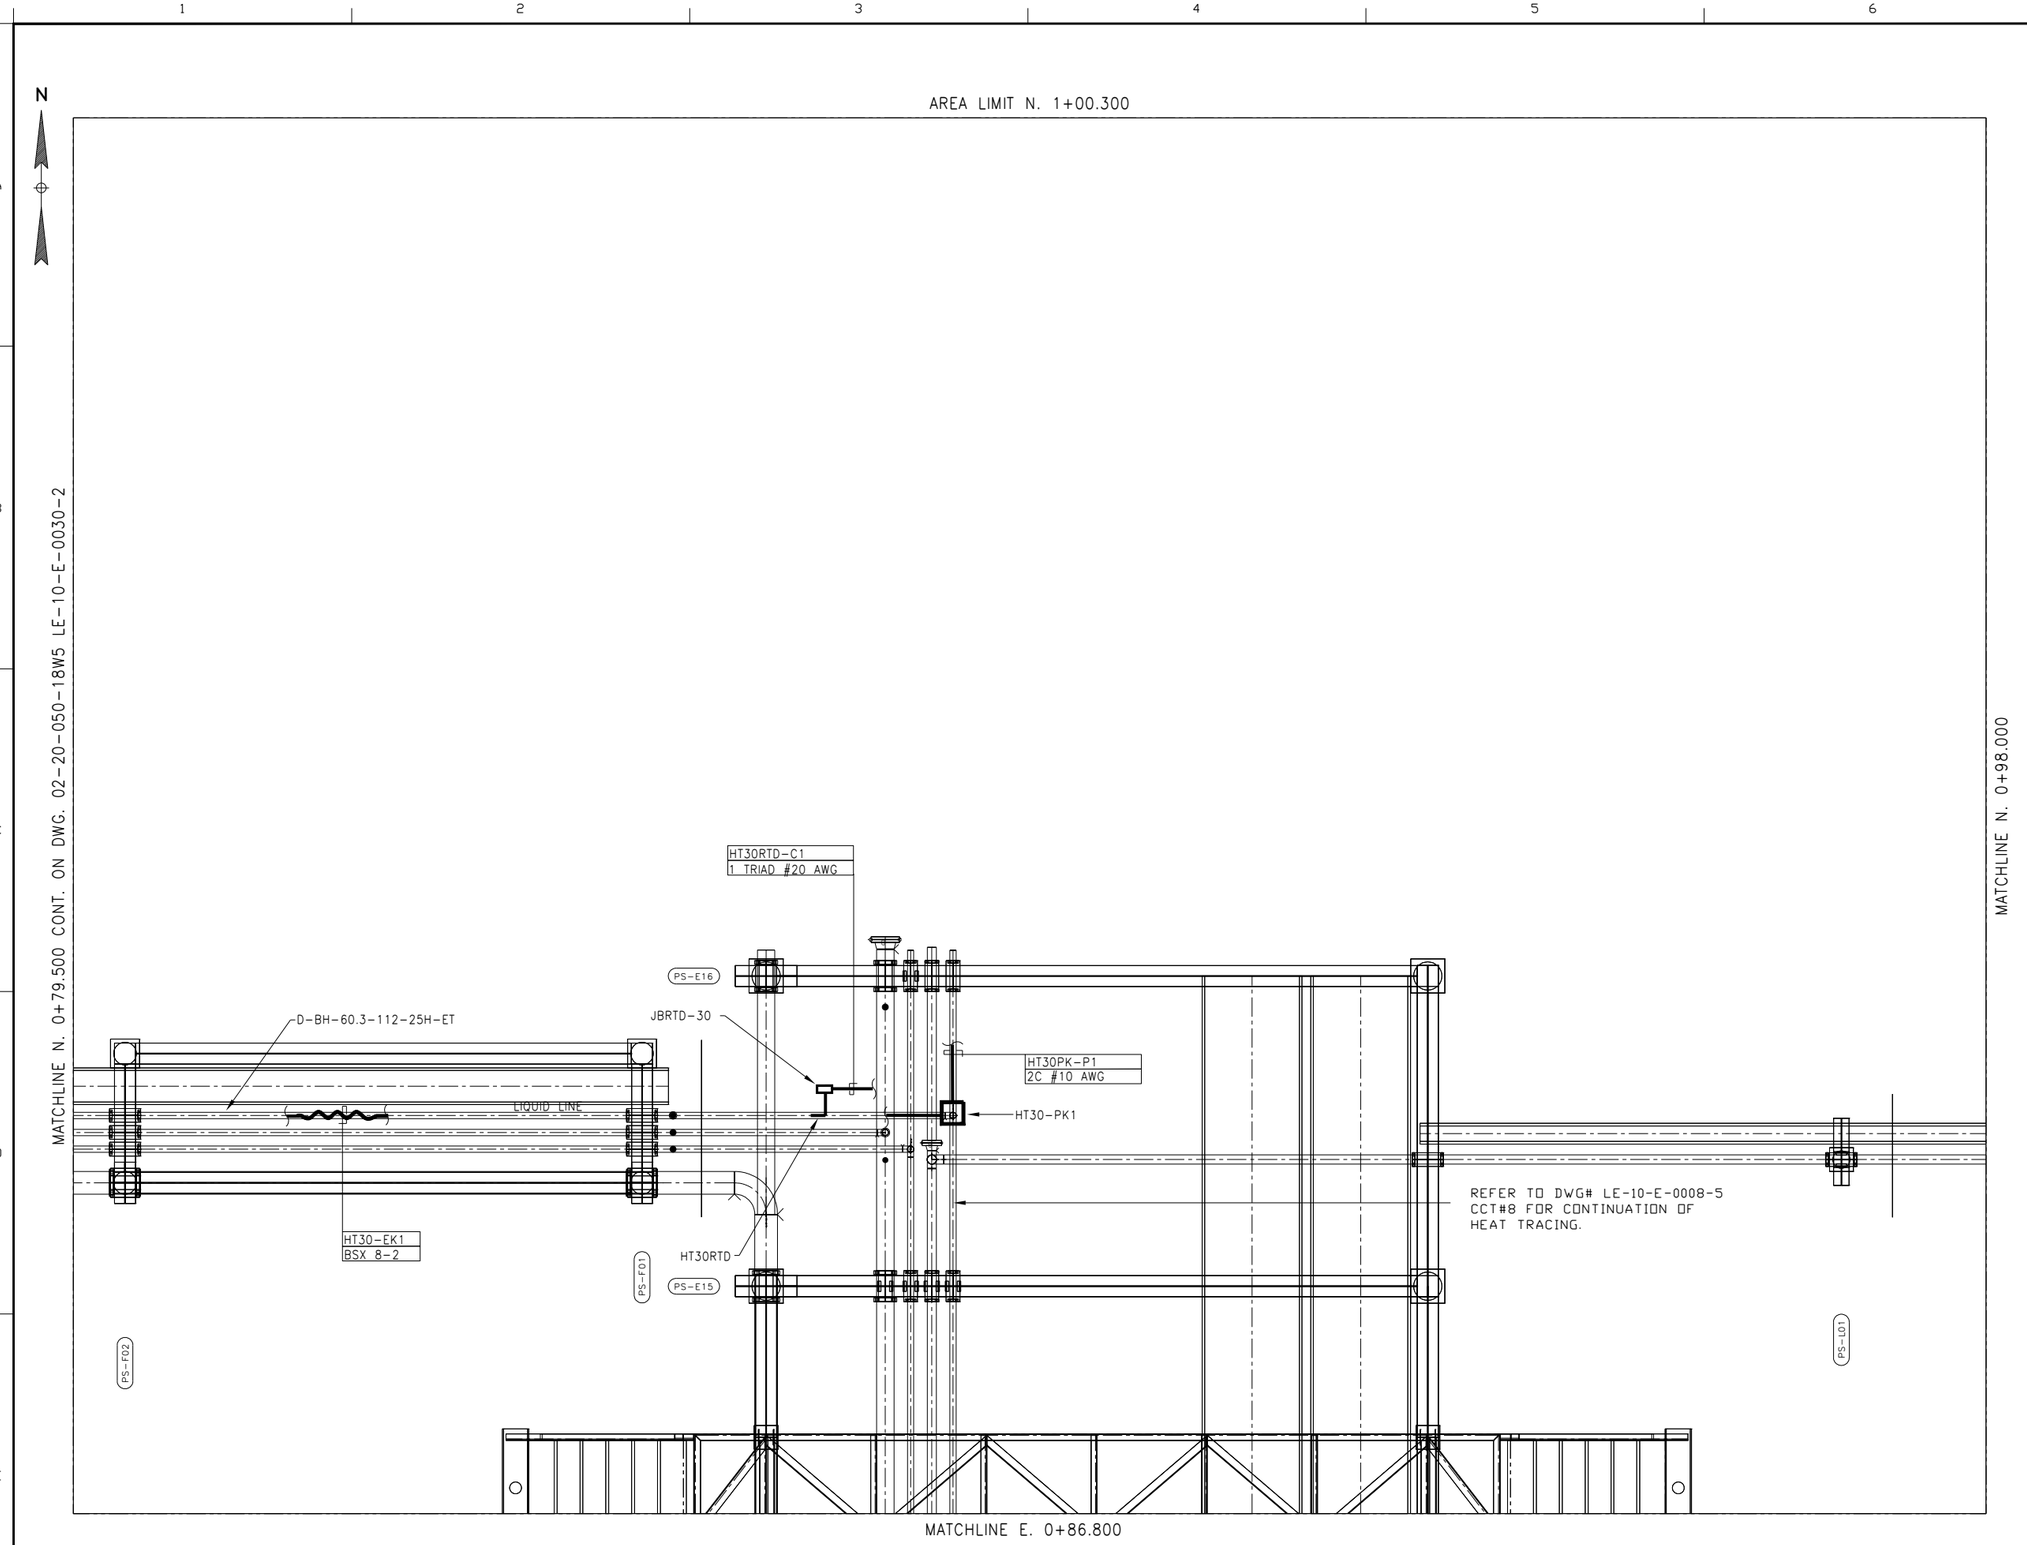

ENGINEERING COMPANY PERMIT STAMP

REGISTERED PROFESSIONAL ENGINEER STAMP

WHEN SIGNED & DATED, THE ENGINEERING SEAL & PERMIT AFFIXED ABOVE WILL APPLY TO THE CLOUDED AREAS FOR THE CURRENT REVISION ONLY.

6		
5		
4		
3		
2		
1		
	DRAWING NUMBER	DRAWING TITLE

REFERENCE DRAWINGS

2	2014/09/04	AS BUILT FOR EWR 18319 EXCELSIOR 3829	AE	SSTJ	FJ	VD
1	2014/03/17	IFC FOR EWR 18319 EXCELSIOR 3829	AM	SSTJ	FJ	VD
	DATE	DESCRIPTION	BY	CHK	ENG	APR

REVISION HISTORY

Husky Oil Operations Limited

EXCELSIOR ENGINEERING LTD

RAVEN CREEK 02-20-050-18W5 COMPRESSOR STN

TITLE

02-20 MCC AREA
HEAT TRACING PLOT PLAN LAYOUT/HT CIRCUIT #30

SURFACE LOCATION	02-20-050-18W5	
ALTERNATE DWG NUMBER	LE-10-E-0030-1	REV NO
HUSKY DWG NUMBER	02-20-050-18W5-ET-0029-01	2
VENDOR DWG NUMBER		SCALE
AMU/FLOC NUMBER	FH-AN-001-00007	1:30
DCN NO	PROJECT NO 3829 EWR 18319	