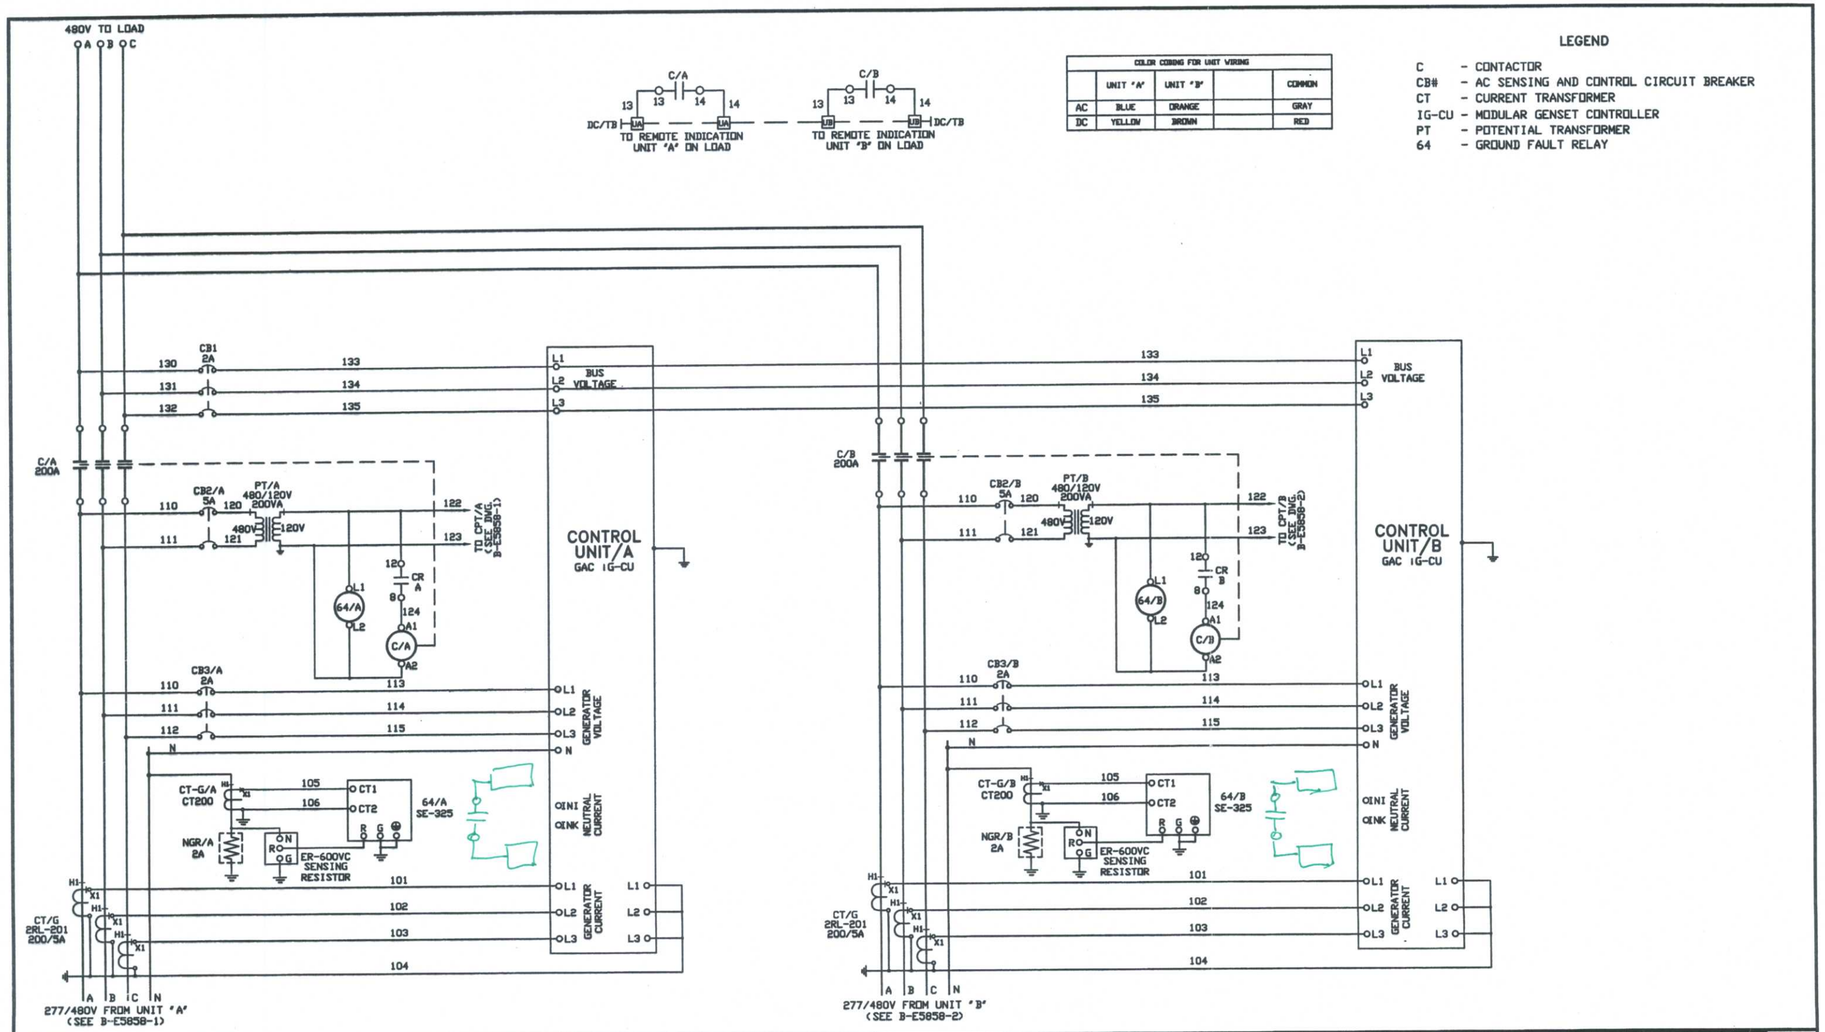

COLOR CODING FOR UNIT WIRING				
	UNIT 'A'	UNIT 'B'		COMMON
AC	BLUE	ORANGE		GRAY
DC	YELLOW	BROWN		RED

LEGEND

C - CONTACTOR
CB# - AC SENSING AND CONTROL CIRCUIT BREAKER
CT - CURRENT TRANSFORMER
IG-CU - MODULAR GENSET CONTROLLER
PT - POTENTIAL TRANSFORMER
64 - GROUND FAULT RELAY

Tartan ENGINEERING

DRAWING REVIEW

REVIEW IS FOR GENERAL COMPLIANCE WITH CONTRACT DOCUMENTS. NO RESPONSIBILITY IS ASSUMED FOR CORRECTNESS OF DESIGN (IF REQUIRED OF THE VENDOR/CONTRACTOR), DIMENSIONS OR DETAILS.

- [ ] NO EXCEPTIONS TAKEN PROCEED WITH CONSTRUCTION
- [x] MAKE CORRECTIONS NOTED PROCEED WITH CONSTRUCTION
- [ ] REVISE AND RESUBMIT

BY _____ DATE 06.06.01
PROJ. NO. 336500 DATE RECEIVED May 25/06

Tartan ENGINEERING

DRAWING CHECK

Department	Circulate to	Initial	Date Received	Date Checked
Piping & Design	JK	JK	May 26/06	
Process	NF		May 31	May 31
Mechanical	JB/GM	JB/GM	MAY 31/06	
Instrument	KB/BW	KB	MAY 31/06	
Systems			June 1/06	
Electrical	JF	JF	MAY 31/06	
Civil & Structural	AB			
Operations				
Project Engineer				
Project Manager	HT			

RETURN TO Bob.B BY May 30/06

THIS DRAWING CONTAINS CONFIDENTIAL INFORMATION OF A PROPRIETARY NATURE TO SIMMAX INC. REPRODUCTION, TRANSMISSION OR USE FOR ANY PURPOSE WITHOUT THE EXPRESS WRITTEN CONSENT OF SIMMAX INC. IS STRICTLY PROHIBITED.

RELEASED TO PRODUCTION

NO CUSTOMER APPROVAL REQUIRED

CUSTOMER:
S/M CALGARY
HUSKY OIL OPERATIONS LTD.
ANSELL - C/O TARTAN ENG.
06C254

NOTES:

NO.	DESCRIPTION
1	ALL WIRING IS #16AWG TYPE TEW

DRAWN BY: G.P.LAPOINTE
CHECKED BY:
DATE: 05/10/06

REVISIONS

NO.	DATE	BY	DESCRIPTION

SIMSON-MAXWELL

TITLE: SCHEMATIC DIAGRAM OF 2 UNIT AC PARALELLING (2 X 110KW) 277/480V,3ø-4W+G,60HZ

SCALE:	DRAWING NO:	REV:	SIZE
N.T.S.	B-E5858	0	B