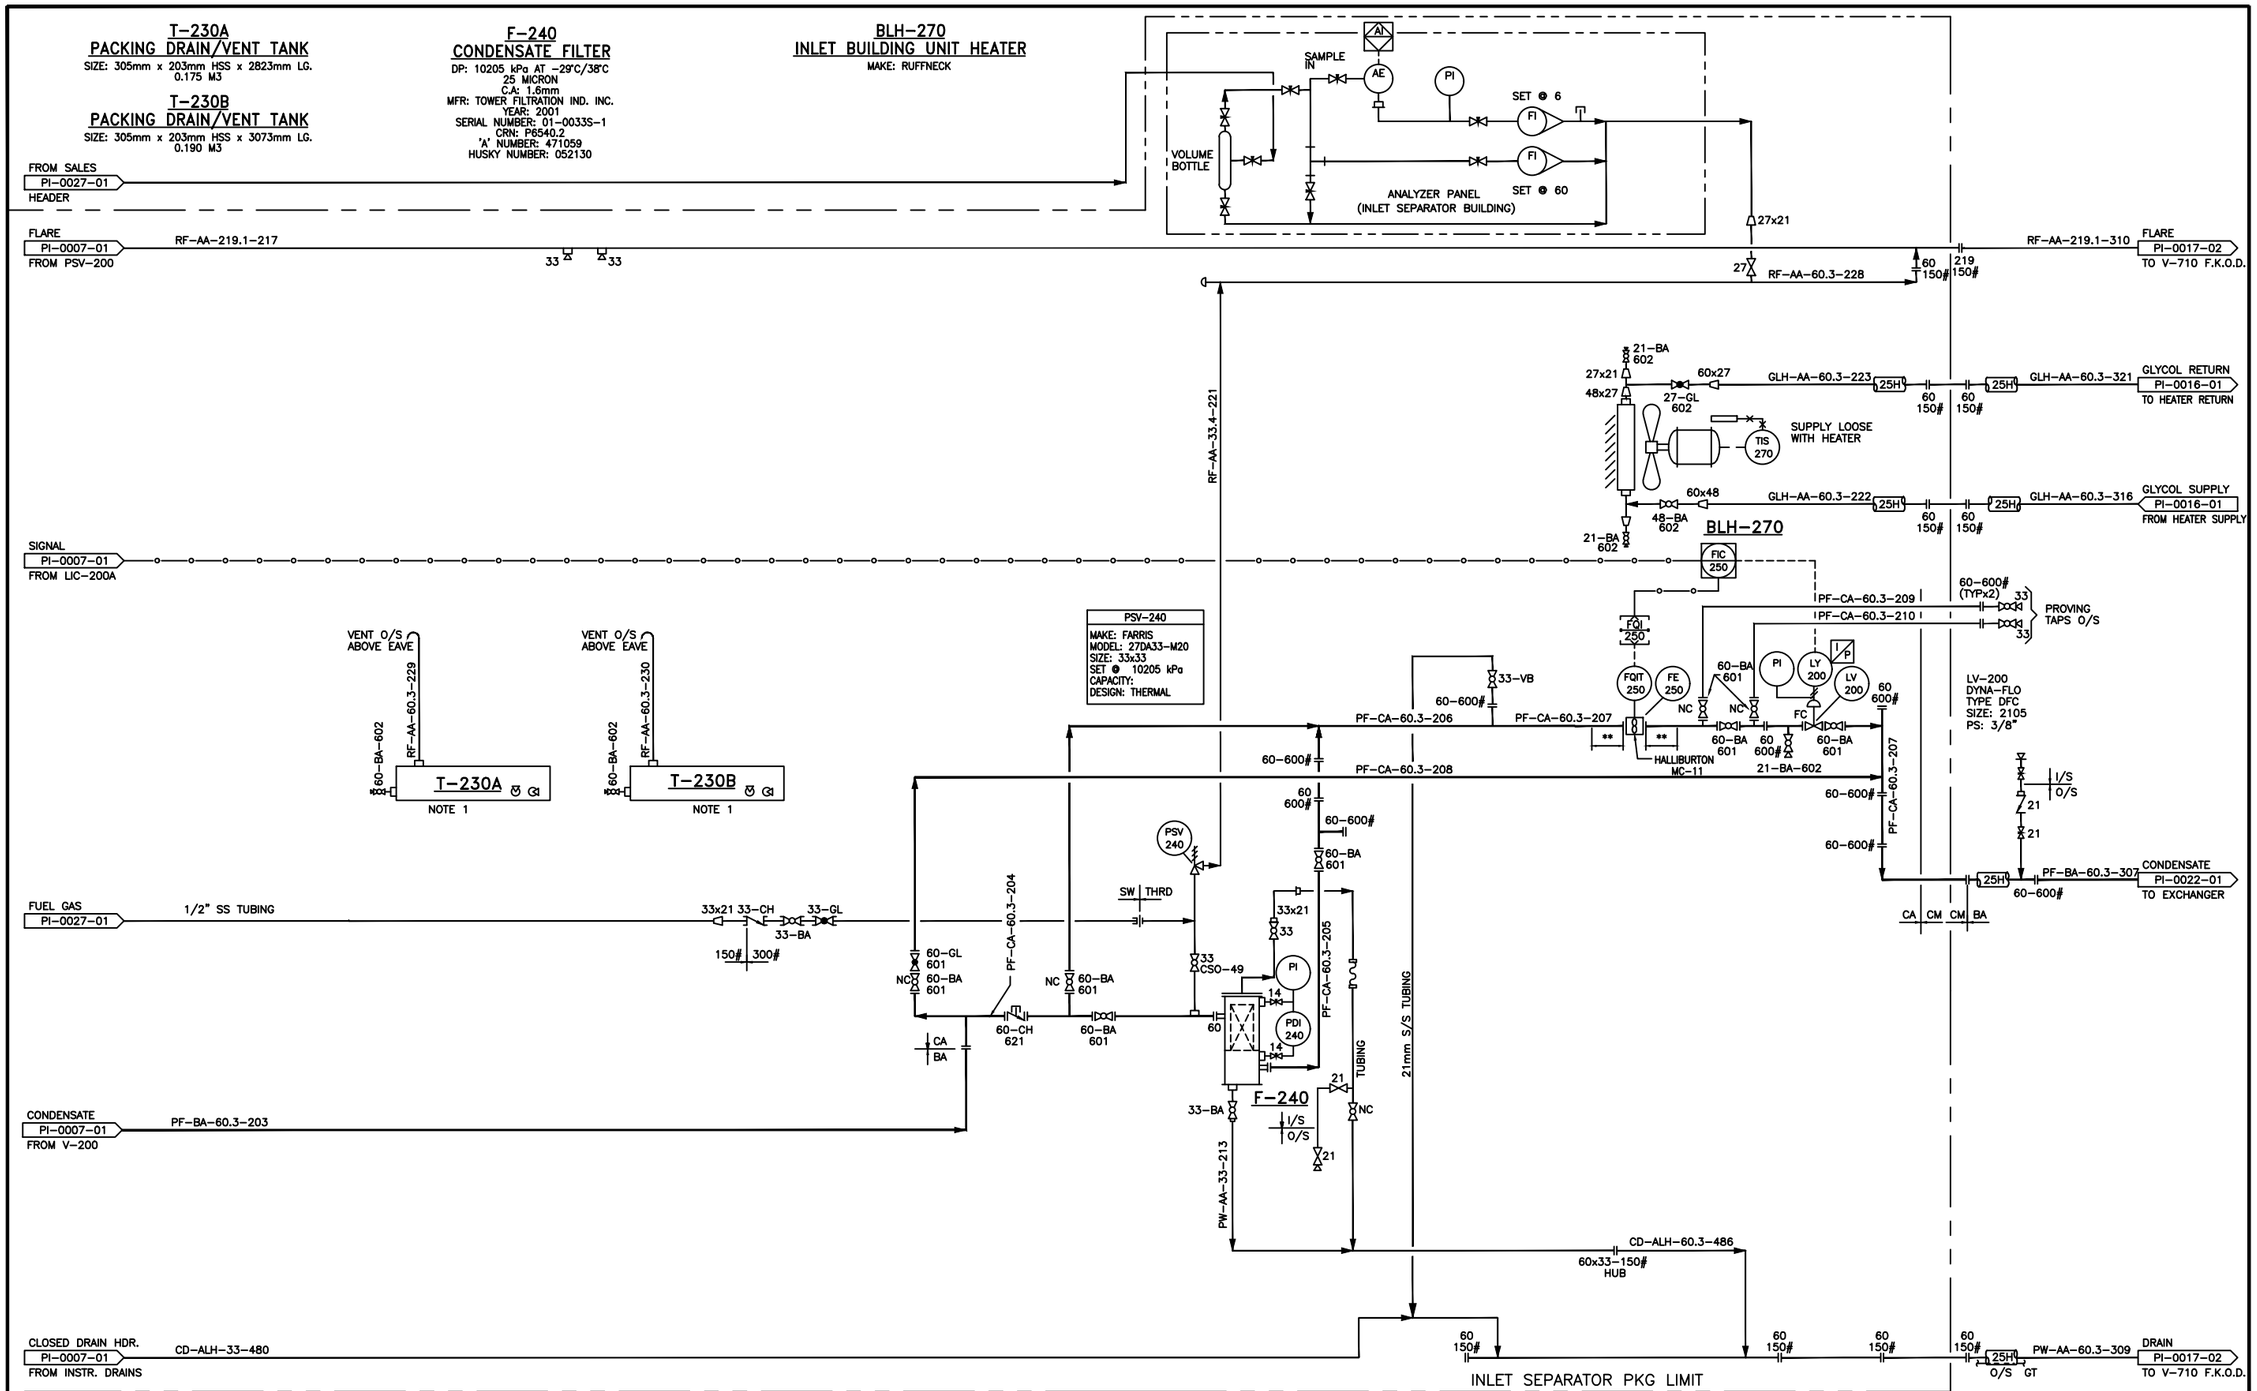

NOTES:

1. TANKS ARE PART OF THE SKID.

NUMBER	TITLE

REFERENCE DRAWINGS

NO.	DATE	DESCRIPTION	BY	APP'D
3	05-06-20	DESIGN REVIEW (TARTAN PROJ. 322000)	ER	
10	2019/09/16	AS BUILT FOR CC 80071407	SK	JJ
9	2018/03/23	AS-BUILT FOR MOC 10894388	LG	CM
8	2016/01/29	AS BUILT FOR MOC 16505775	BOB	CM
7	2015/08/07	IFC FOR PO 8400944388 STANTEC 110901636-1930.1	WEL	IJ
6	2015/03/19	IFC FOR PO 8400944388 STANTEC 110901636-1930.6	WEL	IJ
5	2014/07/23	AS BUILT FOR EWR 19454 STANTEC 110616909	MO	
4	05-06-28	ISSUED FOR CONSTRUCTION (TARTAN PROJ. 322000)	ER	

REVISIONS

JOB NO. PO 8400944388
DRAWN BY STANTEC
CHECKED BY
APPROVED BY
ALTERNATE DWG NO. 2076-11-PI-02

Husky Oil Operations Limited

GALLOWAY 12-05-054-20W5 GAS PLANT
INLET SEPARATOR BLDG.
PIPING & INSTRUMENTATION DIAGRAM

SCALE NTS
FILE
DATE 2019/09/16
REV. 10
DRAWING NO. 12-05-054-20W5-PI-0008-01