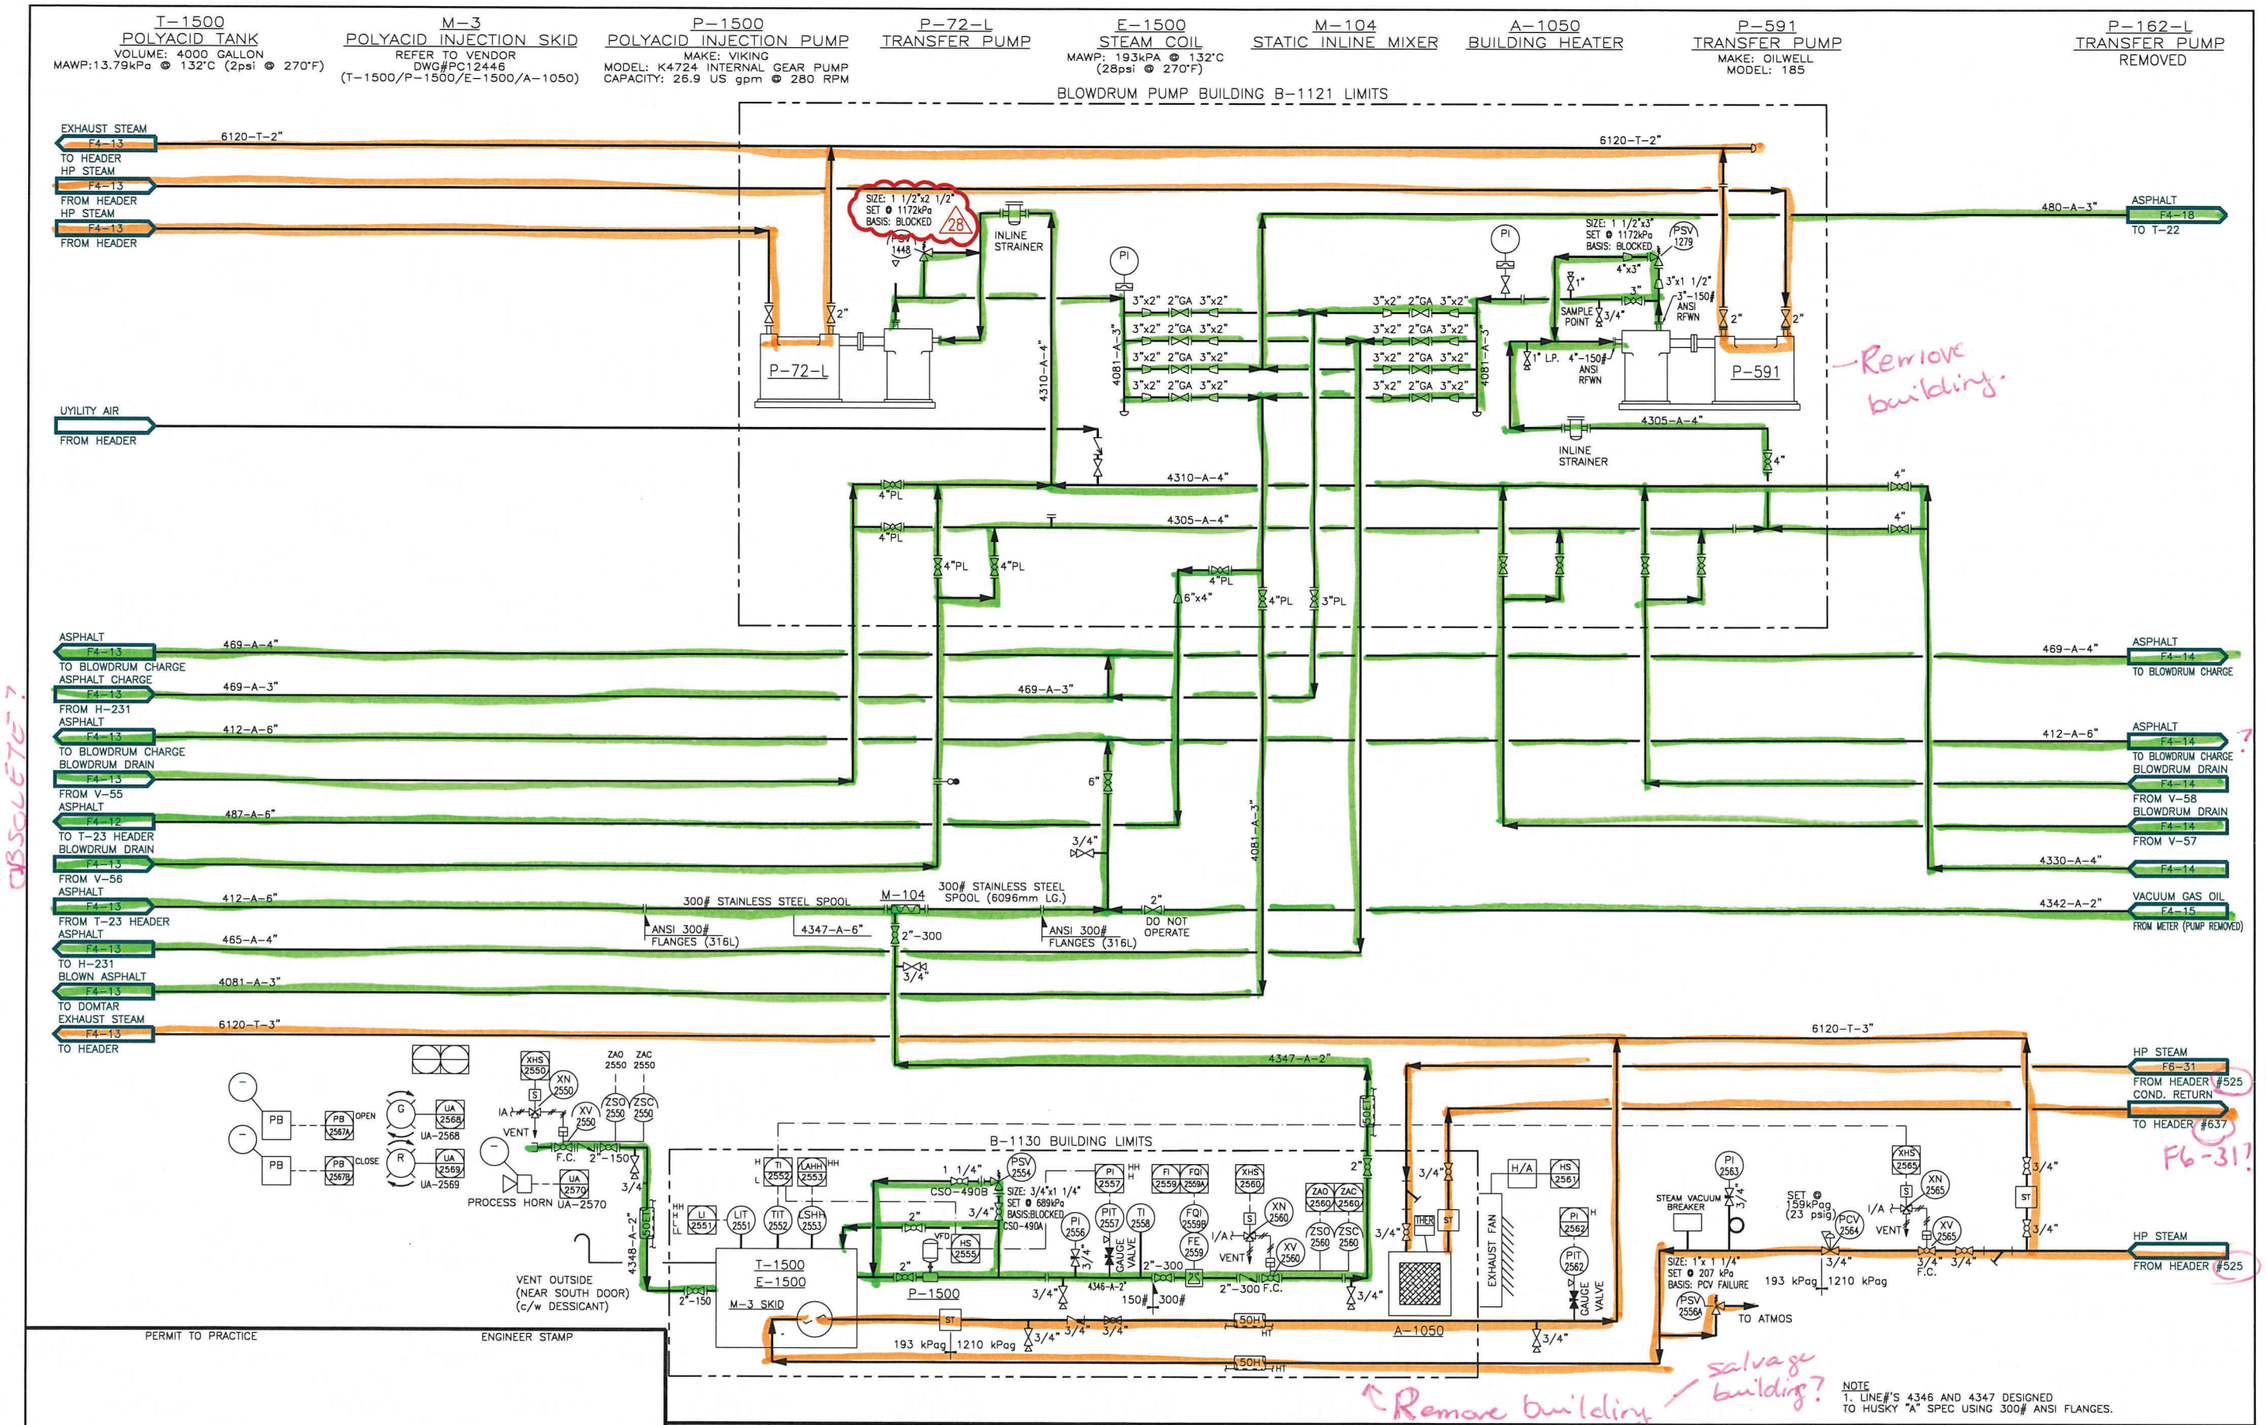

PERMIT TO PRACTICE

ENGINEER STAMP

NUMBER	TITLE
	AS NOTED ON LINE CONTINUATION TAGS

REFERENCE DRAWINGS

NO.	DATE	DESCRIPTION	BY	APP'D
25	2016/01/26	AS BUILT AS PER HLR ENG/PSV STUDY	WD	KP
24	2013/11/20	OFFSITE PID AS-BUILD (PR-12-31 - A-TECH)	JEL	LC
23	2012/10/22	REVISED UNION SYMBOL TO A CHECK VALVE	SP	BS
22	2011/05/20	ADDED ISOLATION VALVES TO PSV-2554	SP	BG
21	2010/04/01	BLOWDRUM V-60 LEVEL DETECTION (EWR# OF-08-18)	RPK	SHS
28	2021/02/01	PSV-1448 HAD INCORRECT SET PRESSURE, CHANGED TO CORRECT SETTING	SP	DL
27	2020/10/23	AS-BUILT AS PER HLR ENG.	SP	MS
26	2018/03/02	ADDED UTILITY AIR, AS PER MAINTENANCE MARK-UP	SP	KP

REVISIONS

NOTE
1. LINE#'S 4346 AND 4347 DESIGNED TO HUSKY "A" SPEC USING 300# ANSI FLANGES.

cenovus ENERGY

DRAWN BY H. JACOBSON	LLOYDMINSTER REFINERY BLENDING AND LOADING PIPING AND INSTRUMENTATION DIAGRAM	SCALE NTS	
CHECKED BY		DATE 80/11/05	FILE R03-05
APPROVED BY		DRAWING NO. F4-37	REV. 28